

MISSISSIPPI DEPARTMENT OF ENVIRONMENTAL QUALITY

Office of Land and Water Resources

P. O. Box 10631
Jackson, MS 39289-0631

WATER WELL DRILLERS LOG

COUNTY WELL LOCATED <i>WilK. HSOH</i>	
WELL NUMBER <i>D</i>	CODED
DATE WELL COMPLETED <i>2008</i> <i>Nov 8, 94</i>	

PERMIT NUMBER
NAME OF DRILLING FIRM <i>FITZGERALD Well Service</i>

NAME & MAILING ADDRESS OF LANDOWNER <i>ALTON BALFAUTZ</i> <i>R.R. Closter, ms</i>			
WELL LOCATION: SEC	TOWNSHIP	RANGE	
<i>11</i>	<i>4</i>	<i>N</i>	<i>1</i>
		<i>S</i>	<i>W</i>
DISTANCE	DIRECTION	NEAREST TOWN	
<i>6 1/2</i> Miles	<i>WNW</i>	<i>Closter</i>	
OTHER LANDMARK			
WELL PURPOSE: Home, Irrigation, Municipal, Industrial, Fish Pond, etc. <i>Home</i>			

PUMP DATA			
PUMP TYPE (Circle One): <input checked="" type="radio"/> Submersible, <input type="radio"/> Turbine, <input type="radio"/> Jet, <input type="radio"/> Flowing Well, Other (Describe) _____			
POWER TYPE (Circle One): <input checked="" type="radio"/> Electric, <input type="radio"/> Tractor, <input type="radio"/> Diesel, <input type="radio"/> Gasoline, <input type="radio"/> Butane, Other (Describe) _____ H/P <i>3/4</i>			
Pump Capacity (GPM) <i>10</i>	No. of Stages <i>12</i>	Setting Depth <i>140</i>	FT.
PUMP TEST			
Well yielded <i>25</i> GPM with a drawdown of <i>2</i> ft. after <i>2</i> hours of pumping			

WELL DATA		
Well Depth <i>150</i>	Casing Diameter (in.) <i>4</i>	Casing Length (Ft.) <i>140</i>
Type of Casing <i>PSC</i>	Hole Depth <i>150</i>	Depth to Static Water Level <i>120</i>

LOG DATA	
TYPE OF LOG RUN (Circle One): <input checked="" type="radio"/> No Log Run, <input type="radio"/> Electric, <input type="radio"/> Gamma Ray, <input type="radio"/> Density, <input type="radio"/> Sonic, <input type="radio"/> Neutron, Other (Describe) _____	
Name of Organization Running Log	

TYPE OF COMPLETION: (Circle One or More): <input checked="" type="radio"/> Gravel Packed, <input type="radio"/> Underreamed, <input type="radio"/> Telescoped, <input type="radio"/> Natural Development, <input type="radio"/> Open Hole, <input type="radio"/> Other (Describe) _____		
--	--	--

GEOLOGIC DATA (Office Use Only)			
Surface Elev.	Geologic Unit	Unit Thickness	Depth to Top
Subs. SWL	Date	Analysis	Aquifer Test

WELL GROUTED TO A DEPTH OF <i>10</i> FEET Type Grout (circle one): Cement, Bentonite, <input checked="" type="radio"/> Mix

Driller's Remarks:	
Top of Lap Pipe or Reduction in Casing	
FEET	IF TELESCOPED OR MORE THAN ONE SCREEN: USE BACK PAGE

SCREEN DATA		
Diameter - Inches <i>4</i>	Length - Feet <i>10</i>	Slot Size - Inches <i>10/12</i>
Screen Type <i>PSC</i>	Depth to Bottom - Feet <i>150</i>	


DESCRIPTION OF FORMATIONS ENCOUNTERED	FROM	TO
<i>Red Clay</i>	<i>0</i>	<i>20</i>
<i>Red Sand</i>	<i>20</i>	<i>70</i>
<i>Coarse Sand & gravel</i>	<i>70</i>	<i>150</i>

FORMATIONS (Continued)	FROM	TO
RECEIVED		
DEC 14 1994		
Dept of Environmental Quality Office of Land & Water Resources		

IF MORE SPACE IS NEEDED, USE BACK

If well telescopes please sketch and show depths.

GROUND LEVEL

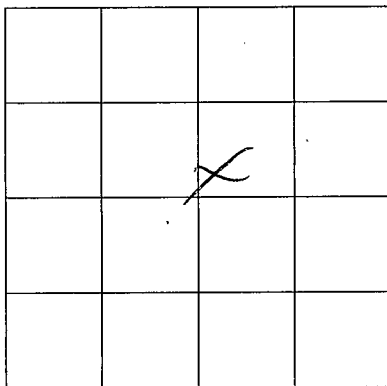

SECTION 11

Please indicate well location X.

ADDITIONAL INFORMATION

Lined area for additional information.

If more than one screen, show location of each on sketch.