

WATER WELL DRILLERS LOG

11-25-61

11-25-61

Date: 11-25-1961, Driller: W. J. Fitzgerald, County Pike

(Name)

(1) Owner of Land: H.C. Leah
956 Pennie Drive
Baton Rouge 15, La.
(Address)

Description & Color of Materials Sand, Clay, Red Clay, Shell, etc.	Thick- ness Feet	Depth Feet
Grumbo Mud & Shale	0	70
Sand gradually gets coarser	70	
coarser		131

(2) Location: 1/4, 1/4, Sec. 36 T3 R44
8 miles EN of Ft Adams
(distance) (direction) (Nearest Town)

(3) Topography: (Flat) (Level) (Hilly)

(4) Purpose of Well: Domestic
(Domestic Irrigation
Municipal, Industrial, Other)


Information upon completion of well:

- (1) Diameter 4" inches.
- (2) Total Depth 131 feet.
- (3) Water Level 15 feet below top of ground.
- (4) Cased to 127, Size 2"
- (5) Screen: Size 1/4, Length 4
- (6) Were any formations sealed against pollution?
yes, no.

CODED

If YES depth of formation
Why

Drillers Remarks: This Well Was
Made on Lake Mary

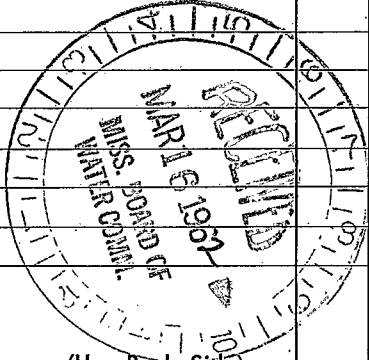

(Use Back-Side)

Well No.

