

CODED

Wilkinson  
E2  
7-68

MISSISSIPPI  
BOARD OF WATER COMMISSIONERS  
416 North State Street  
Jackson, Mississippi 39201

WATER WELL DRILLERS LOG

July 19 1968 Reeswell Drilling Co. Wilkinson  
date well completed firm name county well located

LANDOWNER: Colonial Chevrolet Co.  
Woodville, Miss.  
(mailing address)

description of formations encountered	from	to
top soil	0	8
blue clays	8	91
fine sand	91	170
coarse sand	170	142

WELL LOCATION:  
sec. 23 T. 3 N. R. 4 E  
at Lake Mary -  
(distance) (direction) (nearest town)

WELL PURPOSE: Domestic  
(home, irrigation, municipal, industrial)


WELL COMPLETION DATA:

- (1) diameter (inches) 4"
- (2) total depth (feet) 142
- (3) static water level (feet) 12 below top of ground.
- (4) casing Plastic Ballans (material) (depth)
- (5) screen 6' 136 (length) (depth to top)  
4" Plastic (size) (material)
- (6) pump 1/2 HP 12 (HP) (yield gpm)  
Electric (type power)
- (7) electric log NO (yes or no)

(organization running log)


(8) how well bottom suggests  
waddy plug

DRILLERS REMARKS:  
Camp house

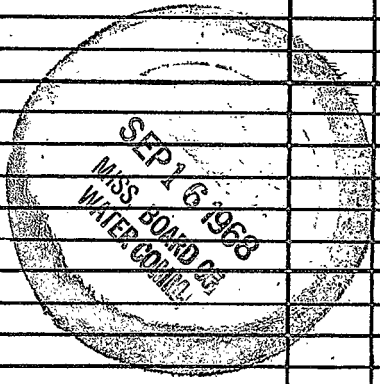

If well telescopes please  
sketch and show depths.

GROUND LEVEL

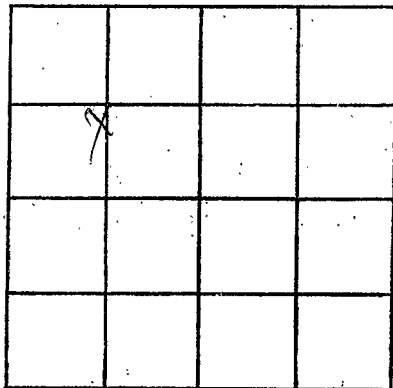

SECTION 23

Please indicate well location X.

ADDITIONAL INFORMATION

If more than one screen,  
show locations of each on sketch.