

abstract

MISSISSIPPI  
BOARD OF WATER COMMISSIONERS  
416 North State Street  
Jackson, Mississippi 39201

Wilkinson  
E3  
3-21-70

3 AD WATER WELL DRILLERS LOG <sup>5/21/70</sup> <sup>Red 6/2/70.</sup>

3/31 1970 Shiner Water Well Ser Wilkinson  
date well completed firm name county well located

LANDOWNER:  
J.W. Sherr  
3169 Sherry  
Patton Range, La 70815  
(mailing address)

description of formations encountered	from	to
Top Soil	0	2
Blue Clay	2	42
Coarse Sand	42	160
Blue Clay	160	178
Coarse Sand & Gravel	178	332

WELL LOCATION: 060  
36 34 T 3 N R 4 E  
sec. T. R. (with N, S, E, W)  
1 1/2 miles West of Woodville  
(distance) (direction) (nearest town)

WELL PURPOSE: Home  
(home, irrigation, municipal, industrial)

- WELL COMPLETION DATA:
- (1) diameter (inches) 2"
  - (2) total depth (feet) 332'
  - (3) static water level (feet) 18' below top of ground.
  - (4) casing Galv. 315'  
(material) (depth)  
2" if telescope see back.  
(size)
  - (5) screen 5' 315'  
(length) (depth to top)  
2" SS  
(size) (material)
  - (6) pump 1 76 gpm  
(HP) (yield gpm)  
elec  
(type power)
  - (7) electric log no  
(yes or no)

*This location puts OK  
This well in Lake Joe  
MAY pump check for  
accuracy. J. Sherr*

(organization running log)  
(8) how well bottom plugged wood plug


APR 21 1970

MISS. BD. OF  
WATER COMM.

DRILLERS REMARKS:

If well telescopes please sketch and show depths.

GROUND LEVEL

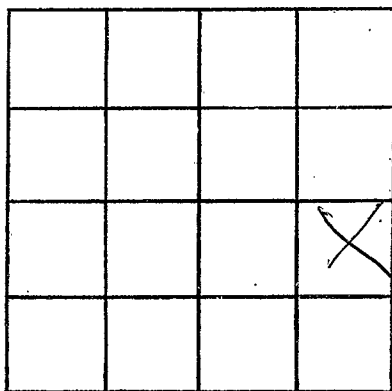

SECTION 31

Please indicate well location X.

ADDITIONAL INFORMATION

If more than one screen,  
show locations of each on sketch.