

WILKINSON  
E 4  
9-23-70

MISSISSIPPI  
BOARD OF WATER COMMISSIONERS  
416 North State Street  
Jackson, Mississippi 39201

**CODED**

WATER WELL DRILLERS LOG

9-23 1970 Griner Water Well Ser. Wilkinson  
date well completed firm name county well located

LANDOWNER:	description of fomations encountered	from	to
<u>M. P. McShaw</u>			
	<u>Clay</u>	<u>2</u>	<u>45'</u>
	<u>Sand</u>	<u>45</u>	<u>155</u>
(mailing address)			
WELL LOCATION:			
sec <u>23</u> T <u>3</u> N R <u>4</u> E			
<u>15</u> miles <u>NW</u> of <u>Woodville</u>			
(distance) (direction) (nearest town)			
WELL PURPOSE: <u>home</u>			
(home, irrigation, municipal, industrial)			
WELL COMPLETION DATA:			
(1) diameter (inches) <u>2"</u>			
(2) total depth (feet) <u>155'</u>			
(3) static water level (feet) <u>30</u> below above top of ground.			
(4) casing <u>Galv.</u> <u>148'</u>			
(material) (depth)			
<u>2"</u> If telescope see back.			
(size)			
(5) screen <u>5'</u> <u>148'</u>			
(length) (depth to top)			
<u>2"</u> <u>SB</u>			
(size) (material)			
(6) pump <u>1/2</u> <u>6 GPM</u>			
(HP) (yield gpm)			
<u>elec.</u>			
(type power)			
(7) electric log <u>no</u>			
(yes or no)			
(organization running log)			
(8) how well bottom plugged <u>Wood Plug</u>			
DRILLERS REMARKS:			


**CODED**

OCT 29 1970

MISS. SD. TR. WATER BOARD

If well telescopes please sketch and show depths.

GROUND LEVEL

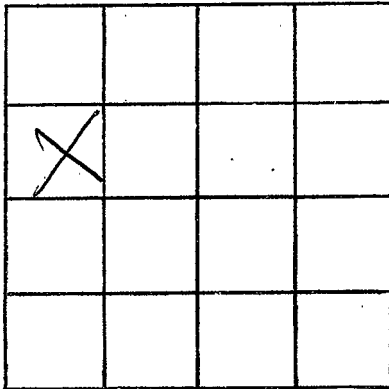

SECTION 23

Please indicate well location X.

ADDITIONAL INFORMATION

If more than one screen, show locations of each on sketch.