

Wells

WILKINSON
E5
2-24-71

MISSISSIPPI
BOARD OF WATER COMMISSIONERS
416 North State Street
Jackson, Mississippi 39201

CODED

WATER WELL DRILLERS LOG

2-24 19 71 Gaines Water Well Dr. Wilkinson
date well completed firm name county well located

LANDOWNER:	description of formations encountered	from	to
<u>Ruster Gibbs</u>			
	<u>Blue clay</u>	<u>2</u>	<u>30</u>
	<u>Fine sand</u>	<u>30</u>	<u>100</u>
(mailing address)	<u>Coarse sand</u>	<u>100</u>	<u>155</u>
WELL LOCATION:			
sec <u>24</u> T <u>3</u> N R <u>4</u> E S			
<u>15</u> miles <u>NW</u> of <u>Woodville</u>			
(distance) (direction) (nearest town)			
WELL PURPOSE: <u>Home</u> (home, irrigation, municipal, industrial)			
WELL COMPLETION DATA:			
(1) diameter (inches) <u>2"</u>			
(2) total depth (feet) <u>155'</u>			
(3) static water level (feet) <u>2'</u> <u>2</u> below above top of ground.			
(4) casing <u>Dub.</u> <u>148'</u> (material) (depth)			
<u>2"</u> (size) if telescope see back.			
(5) screen <u>5'</u> <u>148'</u> (length) (depth to top)			
<u>2"</u> <u>SS.</u> (size) (material)			
(6) pump <u>1/2</u> <u>6</u> (HP) (yield gpm)			
<u>elec.</u> (type power)			
(7) electric log <u>no.</u> (yes or no)			
(organization running log)			
(8) how well bottom plugged <u>wood plug</u>			
DRILLERS REMARKS:			


CODED

MAR 8 - 1971

MISS. BD. OF
WATER COMMISSIONERS

If well telescopes please sketch and show depths.

GROUND LEVEL

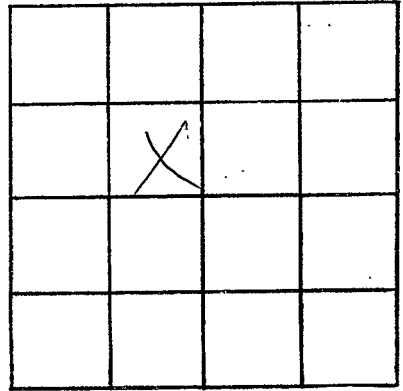

SECTION 24

Please indicate well location X.

ADDITIONAL INFORMATION

If more than one screen, show locations of each on sketch.