

**WILKINSON**  
**E6**  
**9-3-73**

MISSISSIPPI  
 BOARD OF WATER COMMISSIONERS  
 416 North State Street  
 Jackson, Mississippi 39201

**CODED**

**WATER WELL DRILLERS LOG**

9-3-73 1973 Priner Water Well Co. Wilkison  
 date well completed firm name county well located


LANDOWNER:	description of formations encountered	from	to
<u>Johnny L. Scott</u>	<u>Top soil</u>	<u>0</u>	<u>1</u>
<u>Baton Rouge La.</u> (mailing address)	<u>Blue clay</u>	<u>1</u>	<u>35</u>
	<u>fine sand</u>	<u>35</u>	<u>70</u>
	<u>coarse sand</u>	<u>70</u>	<u>152</u>
<b>WELL LOCATION:</b> sec. <u>24</u> T. <u>3</u> (N) S R. <u>4</u> E (W) <u>8</u> miles <u>North</u> of <u>Fort Adams</u> (distance) (direction) of (nearest town)			
<b>WELL PURPOSE:</b> <u>Home</u> (home, irrigation, municipal, industrial)			
<b>WELL COMPLETION DATA:</b> (1) diameter (inches) <u>2"</u> (2) total depth (feet) <u>152'</u> (3) static water level (feet) <u>18'</u> below above top of ground. (4) casing <u>Galv.</u> <u>145'</u> (material) (depth) <u>2"</u> (size) if telescope see back. (5) screen <u>5'</u> <u>145'</u> (length) (depth to top) <u>2"</u> <u>155"</u> (size) (material) (6) pump <u>1/2</u> <u>56gpm</u> (HP) (yield gpm) <u>elec.</u> (type power) (7) electric log <u>no</u> (yes or no) (organization running log) (8) how well bottom plugged <u>Wood Plug</u>			
<b>DRILLERS REMARKS:</b>			

**CODED**

**OCT 12 1973**

If well telescopes please sketch and show depths.

GROUND LEVEL

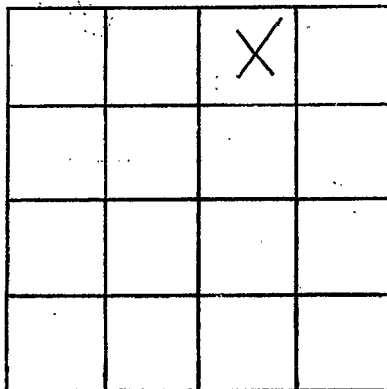

SECTION 23

Please indicate well location X.

ADDITIONAL INFORMATION

A series of 18 horizontal lines for writing additional information.

If more than one screen, show locations of each on sketch.