

MISSISSIPPI DEPARTMENT OF NATURAL RESOURCES

Bureau of Land and Water Resources

Southport Mall

P.O. Box 10631

Jackson, Mississippi 39209

WATER WELL DRILLERS LOG

CODED

WILKINSON
E 11
3/16/81

3-16-81 date well completed

Rayborn Drill. & Const. Co. firm name

Wilkinson, ms county well located

LANDOWNER: Adco Producing
~~Adco Drilling~~
Natchez, ms. 39120
(mailing address)

Description of formations encountered

from to

Top soil	0	2
Bumbo	3	70
coarse sand	70	110
Red gravel & sand	110	130

WELL LOCATION:

sec. 22 T 3 N R 5 E
N 1300' W 700' from SE
12.0 miles (distance) N (direction) of Fort Adams (nearest town)

WELL PURPOSE: Irrigation
(home, irrigation, municipal, industrial)


WELL COMPLETION DATA:

- (1) diameter (inches) 3"
- (2) total depth (feet) 130'
- (3) static water level (feet) 20' below top of ground
- (4) casing Blk. (material) 130' (depth)
3" (size) if telescope see back.
- (5) screen 20' (length) (depth to top)
(size) (material)
- (6) pump 75 (HP) (yield gpm)
(type power)
- (7) electric log no (yes or no)
(organization running log)
- (8) how well bottom plugged wood Plug

DRILLERS REMARKS:

If well telescopes please sketch and show depths.

GROUND LEVEL

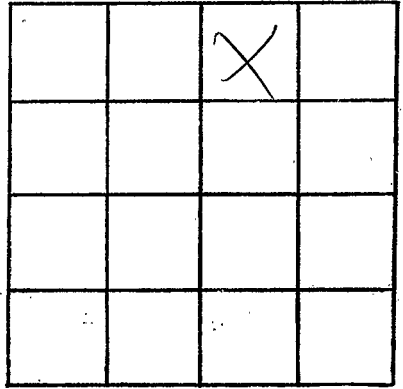

SECTION 22

Please indicate well location X.

ADDITIONAL INFORMATION

If more than one screen, show locations of each on sketch.