

MISSISSIPPI DEPARTMENT OF NATURAL RESOURCES
Bureau of Land and Water Resources
 Southport Mall
 P.O. Box 10631
 Jackson, Mississippi 39209
WATER WELL DRILLERS LOG

CODED

WILKINSON
E 12
8-25-81

8-25 1981 Rayborn Drilling & Const. Co. Wilkinson
 date well completed firm name county well located

LANDOWNER:

Wilcox Drillers
Hatchers, MS
 (milling address)

description of formations encountered

description of formations encountered	from	to
<u>Trop soil</u>	<u>0</u>	<u>2</u>
<u>Clumbo</u>	<u>2</u>	<u>117</u>
<u>Sand</u>	<u>117</u>	<u>145</u>

WELL LOCATION:

sec. 15 T. 3 N. R. 4 E.
7 mi miles east of Lake Mar
 (distance) (direction) (nearest town)

WELL PURPOSE:

(home, irrigation, municipal, industrial)

WELL COMPLETION DATA:

- diameter (inches) 3"
- total depth (feet) 145'
- static water level (feet) 15' below above top of ground.
- casing Blk, 125'
 (material) (depth)
3"
 (size) If telescope see back.
- screen 20', 125'
 (length) (depth to top)
3", slotted pipe
 (size) (material)
- pump -, 456 gpm
 (HP) (yield gpm)
-
 (type power)
- electric log no
 (yes or no)
-
 (organization running log)
- how well bottom plugged wood plug

DEPT. OF NATURAL RESOURCES
 BUREAU OF LAND & WATER RESOURCES


AUG 28 1981

RECEIVED

DRILLERS REMARKS:

If well telescopes please sketch and show depths.

GROUND LEVEL

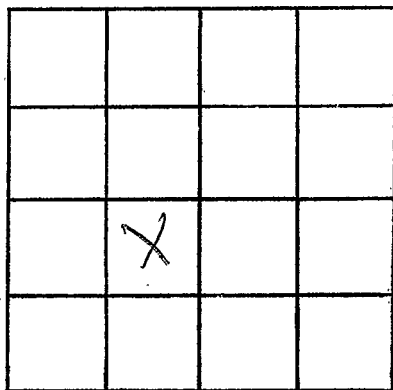

SECTION 15

Please indicate well location X.

ADDITIONAL INFORMATION

If more than one screen,
show locations of each on sketch.