

MISSISSIPPI DEPARTMENT OF NATURAL RESOURCES  
 Bureau of Land and Water Resources  
 Southport Mall  
 P.O. Box 10631  
 Jackson, Mississippi 39209  
**WATER WELL DRILLERS LOG**

CODED

WILKINSON  
 E13  
 9-29-81

9-29-81 date well completed  
 1981 Rayburn Drill & Const. Co. firm name  
 Wilkinson county well located

LANDOWNER:	description of formations encountered	from	to
Wilcox Drillers, Inc Natchez, MS. (mailing address)			
	Clumbo	2	10
	Sand & Gravel	10	90
WELL LOCATION:			
sec. <del>16</del> T-30 N R-5 E 15 S 5 W			
20 miles north of St. Adams (distance) (direction) (nearest town)			
WELL PURPOSE:			
(home, irrigation, municipal, industrial)			
WELL COMPLETION DATA:			
(1) diameter (inches) 3"			
(2) total depth (feet) 90'			
(3) static water level (feet) 10' below top of ground.			
(4) casing PVC, 80' (material) (depth)			
3" (size) if telescope see back.			
(5) screen 30', 60' (length) (depth to top)			
3" (size) slotted Pipe (material)			
(6) pump (HP) 52 GPM (yield gpm)			
(type power)			
(7) electric log no (yes or no)			
(organization running log)			
(8) how well bottom plugged wood plug			
DRILLERS REMARKS:			

330' N + 2400' W of SE corner

CODED


DEPT. OF NATURAL RESOURCES  
 BUREAU OF LAND & WATER RESOURCES

OCT - 6 1981

RECEIVED

If well telescopes please sketch and show depths.

GROUND LEVEL

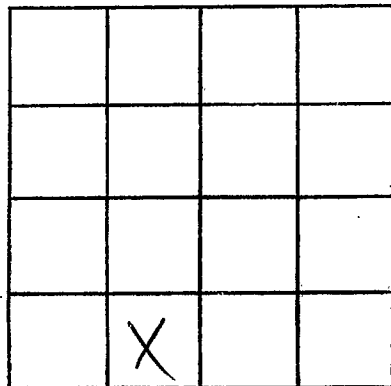

SECTION 20

Please indicate well location X.

ADDITIONAL INFORMATION

If more than one screen,  
show locations of each on sketch.