

MISSISSIPPI DEPARTMENT OF NATURAL RESOURCES

Bureau of Land and Water Resources

Southport Mall

P.O. Box 10631

Jackson, Mississippi 39209

WATER WELL DRILLERS LOG

WILKINSON
E 15
10/19/82

Oct 19
date well completed

1982 Brumfield Well Service
firm name

Wilkinson
county well located

LANDOWNER:	description of formations encountered	from	to
<u>Rebel Drilling Co.</u>	<u>Gumbo</u>	<u>0</u>	<u>36</u>
<u>Sargent Properties Dr. Natchez</u> (mailing address)	<u>Fine Sand</u>	<u>36</u>	<u>70</u>
	<u>Coarse Sand</u>	<u>70</u>	<u>121</u>
WELL LOCATION:			
sec. <u>24</u> T. <u>3</u> N. R. <u>4</u> W. <u>17</u> miles <u>NW</u> of <u>Woodville</u> (distance) (direction) (nearest town)	<u>Radsewing Engr. & Assoc.</u> <u>#1 Worsam P.L.L.C.</u> <u>For NE 1/4 SW 1/4 Sec 24 QW S 1/2</u> <u>also E 1/2 SW 1/4 for 720' Dip</u> <u>W'LY @ RA 1200' to LOC in</u> <u>Sec 24, T3N, R4W</u>		
WELL PURPOSE: <u>For Oil Well</u> (home, irrigation, municipal, industrial)			
WELL COMPLETION DATA:			
(1) diameter (inches) <u>4"</u>			
(2) total depth (feet) <u>121'</u>			
(3) static water level (feet) <u>5'</u> below top of ground.			
(4) casing <u>Plastic</u> , <u>111'</u> (material) (depth)			
<u>4"</u> (size) If telescope see back.			
(5) screen <u>10'</u> , <u>111'</u> (length) (depth to top)			
<u>4"</u> , <u>Plastic</u> (size) (material)			
(6) pump <u>1/2</u> <u>70</u> (HP) (yield gpm)			
<u>Diesel</u> (type power)			
(7) electric log <u>No</u> (yes or no)			
(organization running log)			
(8) how well bottom plugged <u>Backwash</u> <u>Water</u>			
DRILLERS REMARKS:			

CODED


DEPT. OF NATURAL RESOURCES
BUREAU OF LAND & WATER RESOURCES

NOV 16 1982

RECEIVED

If well telescopes please sketch and show depths.

GROUND LEVEL

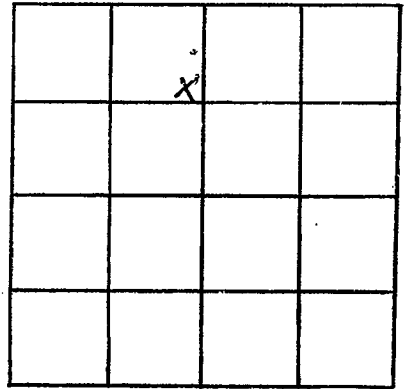

SECTION 24

Please indicate well location X.

ADDITIONAL INFORMATION

If more than one screen,
show locations of each on sketch.