

MISSISSIPPI DEPARTMENT OF NATURAL RESOURCES

Bureau of Land and Water Resources

Southport Mall

P.O. Box 10631

Jackson, Mississippi 39209

WATER WELL DRILLERS LOG

E116  
Wilkinson  
9-8-83

CODED

9-8-83, D T Harris Well serv. firm name  
Wilkinson county well located

LANDOWNER: Pettis Heirs  
Drilled for Energy  
Drilling Co. business.  
P.O. Box 905  
(mailing address)

description of formations encountered	from	to
Combo Sand	0	16'
	16'	82'

WELL LOCATION:  
sec. 33 T 3 N R 4 E  
18 miles N-W of Port Allen  
(distance) (direction) (nearest town)

CODED

WELL PURPOSE: Industrial  
(home, irrigation, municipal, industrial)

Water Supply for Oil Rig

WELL COMPLETION DATA:

(1) diameter (inches) 5"

(2) total depth (feet) 82'

(3) static water level (feet) 15' below top of ground.

(4) casing Plastic 82' (material) (depth)  
3" (size) if telescope see back.

(5) screen 10' 72' (length) (depth to top)  
3" Plastic (size) (material)

(6) pump NO Pump 50 G.P.M. (HP) (yield gpm)  
air compressor (type power)

(7) electric log NO (yes or no)

(organization running log)

(8) how well bottom plugged 3" Cap

3700' N of 3650' W  
of SE 1/4 SEC 33 34 40  
NDI  
Pettis Heirs JR

DRILLERS REMARKS: Drilling  
co. responsible for  
plugging of well


DEPT. OF NATURAL RESOURCES  
BUREAU OF LAND & WATER RESOURCES

OCT 14 1983

RECEIVED

If well telescopes please sketch and show depths.

GROUND LEVEL

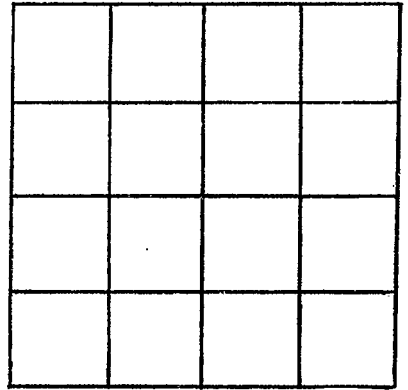

SECTION \_\_\_\_\_

Please indicate well location X.

ADDITIONAL INFORMATION

If more than one screen,  
show locations of each on sketch.