

MISSISSIPPI DEPARTMENT OF NATURAL RESOURCES

Bureau of Land and Water Resources

Southport Mall

P.O. Box 10631

Jackson, Mississippi 39209

WATER WELL DRILLERS LOG

*Wilkinson*  
E 2000

Aug 30 1981  
date well completed

*Peunemiller*  
firm name

*Wilkinson*  
county well located

LANDOWNER:  
*James Leah*  
*Baton Rouge*  
(mailing address)

description of formations encountered	from	to
<i>Clay</i>	<i>0</i>	<i>22</i>
<i>fine cherty sand</i>	<i>22</i>	<i>45</i>
<i>Coarse sand</i>	<i>45</i>	<i>120</i>
<i>piece of gravel</i>	<i>120</i>	<i>130</i>

WELL LOCATION:  
sec. *17* T *3* N R *4* W  
*on Lakes*  
(distance) miles (direction) of (nearest town)

WELL PURPOSE: *camp*  
(home, irrigation, municipal, industrial)

- WELL COMPLETION DATA:
- (1) diameter (inches) *4"*
  - (2) total depth (feet) *130*
  - (3) static water level (feet) *21* below above top of ground.
  - (4) casing *plastic bottom*  
(material) (depth)
  - (size) if telescope see back.
  - (5) screen *5'* *125'*  
(length) (depth to top)
  - (size) (material)
  - (6) pump *3 hp* *10*  
(HP) (yield gpm)
  - (type power)
  - (7) electric log *no*  
(yes or no)
  - (organization running log)
  - (8) how well bottom plugged  
*back with valve*

DRILLERS REMARKS:  
*/*


DEPT. OF NATURAL RESOURCES  
BUREAU OF LAND & WATER RESOURCES

MAR 15 1982

RECEIVED

If well telescopes please sketch and show depths.

GROUND LEVEL

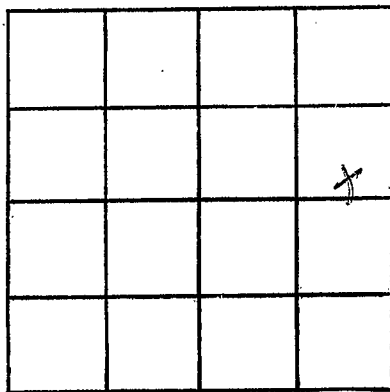

SECTION 17

Please indicate well location X.

ADDITIONAL INFORMATION

If more than one screen,  
show locations of each on sketch.