

Wilkinson
 E 2001

MISSISSIPPI DEPARTMENT OF NATURAL RESOURCES
 Bureau of Land and Water Resources
 Southport Mall
 P.O. Box 10631
 Jackson, Mississippi 39209
WATER WELL DRILLERS LOG

8-12 1982 *Rayburn Drilling & Const. Co. Wilkinson*
 date well completed firm name county well located

LANDOWNER:
Energy Drilling Co.
Natchez, MS. 39120
 (mailing address)

description of formations encountered	from	to
<i>quartz</i>	<i>0</i>	<i>25</i>
<i>sand</i>	<i>25</i>	<i>75</i>

WELL LOCATION:
 sec *33* T *3* N R *4* E
 (distance) miles (direction) of (nearest town)

WELL PURPOSE:
 (home, irrigation, municipal, industrial)

- WELL COMPLETION DATA:
- (1) diameter (inches) *3"*
 - (2) total depth (feet) *75'*
 - (3) static water level (feet) *15'* below above top of ground. *Mc. Hee #1*
 - (4) casing *galv.* *3"* (material), *55'* (depth)
3" (size) if telescope see back.
 - (5) screen *20'* (length), *55'* (depth to top)
3" (size), *slotted pipe* (material)
 - (6) pump *—* (HP), *50 GPM* (yield gpm)
 (type power)
 - (7) electric log *no* (yes or no)
 (organization running log)
 - (8) how well bottom plugged *wood plug*

DRILLERS REMARKS:


DEPT. OF NATURAL RESOURCES
 BUREAU OF LAND & WATER RESOURCES

SEP - 2 1982

RECEIVED

If well telescopes please sketch and show depths.

GROUND LEVEL

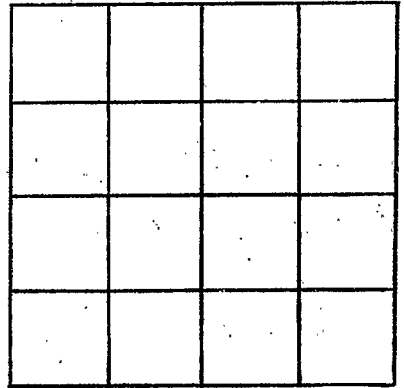

SECTION _____

Please indicate well location X.

ADDITIONAL INFORMATION

If more than one screen,
show locations of each on sketch.