

Wilkinson
E 2002

MISSISSIPPI
BOARD OF WATER COMMISSIONERS
416 North State Street
Jackson, Mississippi 39201

WATER WELL DRILLERS LOG

July 10 1982 Brunfield Well Serv. Wilkinson
date well completed firm name county well located

LANDOWNER: SHAMROCK Drilling Co	description of formations encountered	from	to
	Silt Clay	0	30
Naches Miss	Sand	30	95
(mailing address)	Red Gravel	95	113

WELL LOCATION:
sec. 30 T 31 N R. 4 E
15 miles N.W. Woodville
(distance) (direction) (nearest town)

WELL PURPOSE: Oil Well
(home, irrigation, municipal, industrial)

- WELL COMPLETION DATA:
- (1) diameter (inches) 3"
 - (2) total depth (feet) 113
 - (3) static water level (feet) 33 below above top of ground.
 - (4) casing Plastic 100' (material) (depth)
3" (size) If telescope see back.
 - (5) screen 13' 100' (length) (depth to top)
3 Plastic (size) (material)
 - (6) pump 1/2 HP 95 (HP) (yield gpm).
Diesel (type power)
 - (7) electric log 170 (yes or no)

(organization running log)
(8) how well bottom plugged Solid CAP

DRILLERS REMARKS:


DEPT. OF NATURAL RESOURCES
BUREAU OF LAND & WATER RESOURCES

SEP - 3 1982

RECEIVED

If well telescopes please sketch and show depths.

GROUND LEVEL

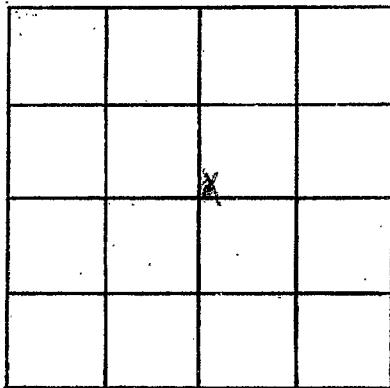

SECTION 30

Please indicate well location X.

ADDITIONAL INFORMATION

*This Well Already
Destroyed, Oil Take 11
dry.*

show

reen,
on sketch.