

MISSISSIPPI DEPARTMENT OF NATURAL RESOURCES

Bureau of Land and Water Resources

Southport Mall

P.O. Box 10631

Jackson, Mississippi 39209

WATER WELL DRILLERS LOG

*Wilkinson*  
*E 2003*

*1-12* 19 *83* *Rayburn Drill. & Const. Co. Wilkinson*  
 date well completed firm name county well located

LANDOWNER:	description of formations encountered	from	to
<i>Shamrock Drilling</i>			
<i>Matches ms 39100</i> (mailing address)	<i>chault.</i>	<i>4</i>	<i>200</i>
WELL LOCATION:	<i>sand</i>	<i>200</i>	<i>230</i>
sec. <i>34</i> T. <i>3</i> R. <i>4</i> S W	<i>salty sand</i>	<i>230</i>	<i>288</i>
(distance) miles (direction) of (nearest town)	<i>sand</i>	<i>288</i>	<i>300</i>
WELL PURPOSE: (home, irrigation, municipal, industrial)			
WELL COMPLETION DATA:			
(1) diameter (inches) <i>3"</i>			
(2) total depth (feet) <i>300'</i>			
(3) static water level (feet) <i>100'</i> below above top of ground.			
(4) casing <i>BLW</i> <i>280'</i> (material) (depth)	<i>Wadley</i>		
<i>3"</i> (size) if telescope see back.			
(5) screen <i>20'</i> <i>280'</i> (length) (depth to top)			
<i>3"</i> <i>Slotted Pipe</i> (size) (material)			
(6) pump <i>52 Gpm</i> (HP) (yield gpm)			
(type power)			
(7) electric log <i>no</i> (yes or no)			
(organization running log)			
(8) how well bottom plugged <i>Wood Plug</i>			
DRILLERS REMARKS:			


DEPT. OF NATURAL RESOURCES  
 BUREAU OF LAND & WATER RESOURCES

FEB 22 1983

RECEIVED

If well telescopes please  
sketch and show depths.

GROUND LEVEL

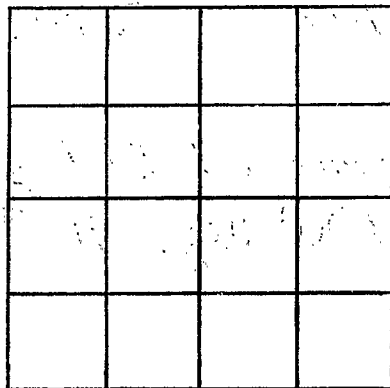

SECTION \_\_\_\_\_

Please indicate well location X.

ADDITIONAL INFORMATION

If more than one screen,  
show locations of each on sketch.