

**MISSISSIPPI DEPARTMENT OF NATURAL RESOURCES**  
**Bureau of Land and Water Resources**  
 Southport Mall  
 P.O. Box 10631  
 Jackson, Mississippi 39209  
**WATER WELL DRILLERS LOG**

Willkerson  
E 2008

10-21-83 19 DJ Harris Well service Willkerson  
 date well completed firm name county well located

LANDOWNER: <u>Passford Sr.</u> <u>Drill for Adeo Drilling</u> <u>Co.</u> (mailing address)	description of formations encountered	from	to
	<u>Gumbo</u>	<u>0</u>	<u>46</u>
	<u>silt</u>	<u>46</u>	<u>100</u>
	<u>coarse sand</u>	<u>120</u>	<u>112</u>
<b>WELL LOCATION:</b>			
sec. <u>8</u> T. <u>3</u> N. R. <u>4</u> E <small>§ W</small>			
<u>15</u> miles <u>North</u> of <u>Lake Mary</u> <small>(distance) (direction) (nearest town)</small>			
<b>WELL PURPOSE:</b> <u>Ind.</u> <small>(home, irrigation, municipal, industrial)</small>			
<b>WELL COMPLETION DATA:</b>			
(1) diameter (inches) <u>5</u>			
(2) total depth (feet) <u>119</u>			
(3) static water level (feet) <u>14</u> below above <small>top of ground.</small>			
(4) casing <u>Plastic</u> , <u>119</u> <small>(material) (depth)</small>			
<u>3</u> <small>(size)</small> if telescope see back.			
(5) screen <u>10'</u> , <u>109</u> <small>(length) (depth to top)</small>			
<u>3"</u> , <u>Plastic</u> <small>(size) (material)</small>			
(6) pump <u>NONE</u> <small>(HP) (yield gpm)</small> <u>air compressor</u> <small>(type power)</small>			
(7) electric log <u>NO.</u> <small>(yes or no)</small>			
<u>(organization running log)</u>			
(8) how well bottom plugged <u>3" plastic</u> <u>cap</u>			
<b>DRILLERS REMARKS:</b> <u>Dil company</u> <u>is to plug well before</u> <u>leaving location.</u>			


DEPT. OF NATURAL RESOURCES  
 BUREAU OF LAND & WATER RESOURCES

NOV - 9 1983

**RECEIVED**

If well telescopes please sketch and show depths.

GROUND LEVEL

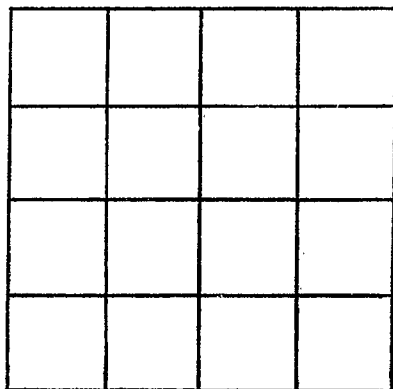

SECTION \_\_\_\_\_

Please indicate well location X.

ADDITIONAL INFORMATION

If more than one screen, show locations of each on sketch.