

Walker
E 2005

MISSISSIPPI DEPARTMENT OF NATURAL RESOURCES
 Bureau of Land and Water Resources
 Southport Mall
 P.O. Box 10631
 Jackson, Mississippi 39209
WATER WELL DRILLERS LOG

9-11-83 19
 date well completed

DJ Harris Well Serv. Jonesville
 firm name Loc. 71343

Willkerson
 county well located

LANDOWNER: Breaux
 well owner: Adco Drilling Co.
Natchez Miss
 (mailing address)

description of formations encountered	from	to
<u>Gumbo</u>	<u>0</u>	<u>80'</u>
<u>Coarsu sand</u>	<u>80'</u>	<u>92'</u>

WELL LOCATION:
 sec. 13 T 8 N R 4 E
5 W
11 miles N of Lake Maru
 (distance) (direction) (nearest town)

WELL PURPOSE: IND.
 (home, irrigation, municipal, industrial)

WELL COMPLETION DATA:

- (1) diameter (inches) 5
- (2) total depth (feet) 92'
- (3) static water level (feet) 16 below above top of ground.
- (4) casing Plastic, 82'
 (material) (depth)
3" if telescope see back.
 (size)
- (5) screen Plastic, 82'
 (length) (depth to top)
3, Plastic
 (size) (material)
- (6) pump NONE
 (HP) (yield gpm)
 (type power)
- (7) electric log. (yes or no) _____
 (organization running log) _____

(8) how well bottom plugged Pre War 10'
deep & cement bored around

DRILLERS REMARKS: This well
pumped by air bar 15 days
and then plugged by well
owner.


DEPT. OF NATURAL RESOURCES
 BUREAU OF LAND & WATER RESOURCES

DEC 16 1983

RECEIVED

If well telescopes please sketch and show depths.

GROUND LEVEL

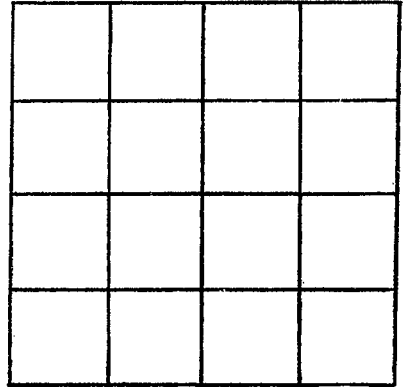

SECTION _____

Please indicate well location X.

ADDITIONAL INFORMATION

If more than one screen,
show locations of each on sketch.