

MISSISSIPPI DEPARTMENT OF NATURAL RESOURCES

Bureau of Land and Water Resources

Southport Mall

P.O. Box 10631

Jackson, Mississippi 39209

WATER WELL DRILLERS LOG

O. J. HARRIS

520 HWY. 124 N.

JONESVILLE, LA 71343

WILKERSON County

Wilkinson
Essex

7-20-1984
date well completed

firm name

county well located

LANDOWNER: <u>Adco Drilling</u>	Description of formations encountered	from	to
<u>Co. 114 JEFF DAVIS</u>			
<u>Natchez, Miss 39120</u> (mailing address)	<u>Silt</u> <u>COARSE</u>	<u>0</u> <u>60</u>	<u>60</u> <u>85</u>
WELL LOCATION:			
sec. <u>2</u> T. <u>3</u> N. R. <u>4</u> E <u>2</u> miles <u>N</u> of <u>LAKE MARY</u> (distance) (direction) (nearest town)			
WELL PURPOSE: <u>INDUSTRIAL</u> (home, irrigation, municipal, industrial)			
WELL COMPLETION DATA:			
(1) diameter (inches) <u>5 1/4</u>			
(2) total depth (feet) <u>85</u>			
(3) static water level (feet) <u>18</u> below top of ground.			
(4) casing <u>plastic</u> , <u>75</u> (material) (depth)			
<u> </u> if telescope see back. (size)			
(5) screen <u>10'</u> , <u>75</u> (length) (depth to top)			
<u>3</u> , <u>plastic</u> (size) (material)			
(6) pump <u>NONE</u> (HP) (yield gpm)			
<u>AIR COMPRESSOR</u> (type power)			
(7) electric log <u> </u> (yes or no)			
<u> </u> (organization running log)			
(8) how well bottom plugged <u>3" plastic</u> <u>CAP</u>			
DRILLERS REMARKS:			


DEPT. OF NATURAL RESOURCES
BUREAU OF LAND & WATER RESOURCES

AUG 14 1984

RECEIVED

If well telescopes please
sketch and show depths.

GROUND LEVEL

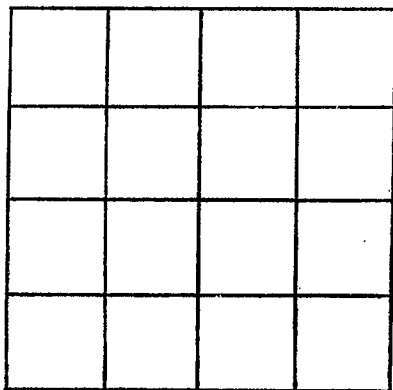

SECTION _____

Please indicate well location X.

ADDITIONAL INFORMATION

If more than one screen,
show locations of each on sketch.