

MISSISSIPPI DEPARTMENT OF NATURAL RESOURCES

Bureau of Land and Water Resources

P.O. Box 10631

Jackson, Mississippi 39209

WATER WELL DRILLERS LOG

COUNTY WELL LOCATED Wilkin Son	
WELL NUMBER E	CODED
DATE WELL COMPLETED 2007	

PERMIT NUMBER
NAME OF DRILLING FIRM RAY BORN DRILLING INC
Natchez, ms

NAME & MAILING ADDRESS OF LANDOWNER DEER HAVEN Hunting Club INC			
101 WEST RAILROAD AVE			
Ridgeland, ms 39157			
WELL LOCATION:	SEC	TOWNSHIP	RANGE
	18	T3	N SR4 E
DISTANCE	DIRECTION	NEAREST TOWN	
9 Miles	NORTH	EAST ADAMS	
OTHER LANDMARK			
WELL PURPOSE: Home, Irrigation, Municipal, Industrial, Fish Pond, etc. Home			

PUMP DATA		
PUMP TYPE (Circle One): <input checked="" type="radio"/> Submersible, <input type="radio"/> Turbine, <input type="radio"/> Jet <input type="radio"/> Flowing Well, Other (Describe) _____		
POWER TYPE (Circle One): <input checked="" type="radio"/> Electric, <input type="radio"/> Tractor, <input type="radio"/> Diesel, <input type="radio"/> Gasoline, <input type="radio"/> Butane, Other (Describe) _____		
Pump Capacity (GPM) 10	No. of Stages 15	Setting Depth 200 FT.
PUMP TEST		
Well yielded 10 GPM with a drawdown of _____ ft. after _____ hours of pumping		


WELL DATA		
Well Depth 375'	Casing Diameter (In.) 4"	Casing Length (Ft.) 355'
Type of Casing Sch 40 Rev	Hole Depth 375'	Depth to Static Water Level 15'
TYPE OF COMPLETION: (Circle One or More): <input checked="" type="checkbox"/> Gravel Packed, <input type="checkbox"/> Underreamed, <input type="checkbox"/> Telescoped, <input checked="" type="checkbox"/> Natural Development, <input type="checkbox"/> Open Hole, <input type="checkbox"/> Other (Describe) _____		
Top of Lap Pipe or Reduction in Casing FEET <input type="checkbox"/> IF TELESCOPED OR MORE THAN ONE SCREEN: USE BACK PAGE		

LOG DATA	
TYPE OF LOG RUN (Circle One): <input checked="" type="radio"/> No Log Run, <input type="radio"/> Electric, <input type="radio"/> Gamma Ray, <input type="radio"/> Density, <input type="radio"/> Sonic, <input type="radio"/> Neutron, Other (Describe) _____	
Name of Organization Running Log	

SCREEN DATA		
Diameter - Inches 4"	Length - Feet 20'	Slot Size - Inches .012
Screen Type Sch 40 Slotted PVC	Depth to Bottom - Feet 375'	

GEOLOGIC DATA (Office Use Only)			
Surface Elev.	Geologic Unit	Unit Thickness	Depth to Top
Subs. SWL	Date	Analysis	Aquifer Test
Driller's Remarks			

DESCRIPTION OF FORMATIONS ENCOUNTERED	FROM	TO
Top soil	0	2
SAND	2	195
CHALK	195	215
SAND	215	375

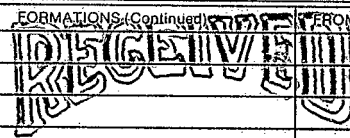 DEC 19 1991 Dept. of Environmental Quality Bureau of Land & Water Resources	FROM	TO

IF MORE SPACE IS NEEDED, USE BACK


If well telescopes please sketch and show depths.

GROUND LEVEL

SECTION _____

Please indicate well location X.

ADDITIONAL INFORMATION

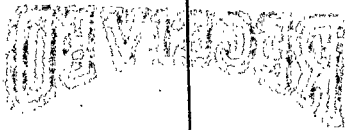

DEVELOPMENT

If more than one screen,
show location of each on sketch.