

**MISSISSIPPI DEPARTMENT OF NATURAL RESOURCES**  
**Bureau of Land and Water Resources**  
 Southport Mall  
 P.O. Box 10631  
 Jackson, Mississippi 39209  
**WATER WELL DRILLERS LOG**

Willerson  
BE  
2014

10-9-83 19 DJ Harris Well serv. Willerson  
 date well completed firm name county well located

**LANDOWNER:** McKee  
Drilled for Energy  
Drilling Co.  
 (mailing address)

description of formations encountered	from	to
<u>Gumbo</u>	<u>0</u>	<u>60</u>
<u>Silt</u>	<u>60</u>	<u>85</u>
<u>Coarse sand</u>	<u>85</u>	<u>96</u>

**WELL LOCATION:**  
 sec. 33 T. 3 N R. 4 E  
6 miles NW of Fort Adams  
 (distance) (direction) (nearest town)

**WELL PURPOSE:** IND  
 (home, irrigation, municipal, industrial)


- WELL COMPLETION DATA:**
- (1) diameter (inches) 3
  - (2) total depth (feet) 96
  - (3) static water level (feet) 12 below above top of ground.
  - (4) casing Plastic, 96'  
 (material) (depth)  
3"  
 (size) if telescope see back.
  - (5) screen 10', 86'  
 (length) (depth to top)  
3", plastic  
 (size) (material)
  - (6) pump NONE  
 (HP) (yield gpm)  
air compressor  
 (type power)
  - (7) electric log (yes or no) \_\_\_\_\_  
 (organization running log)
  - (8) how well bottom plugged 3" Plastic cap

**DRILLERS REMARKS:** Dil company is responsible for plugging well when leaving location

DEPT. OF NATURAL RESOURCES  
 BUREAU OF LAND & WATER RESOURCES  
 NOV 25 1983  
**RECEIVED**

If well telescopes please  
sketch and show depths.

GROUND LEVEL

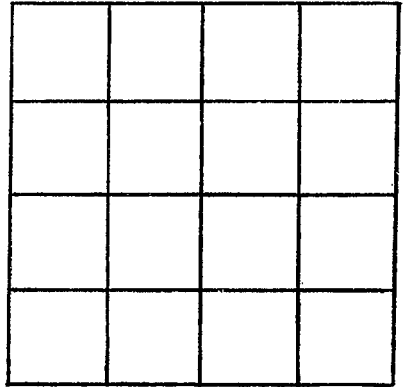

SECTION \_\_\_\_\_

Please indicate well location X.

ADDITIONAL INFORMATION

If more than one screen,  
show locations of each on sketch.