

LK, F 2

5-29-63

WATER WELL DRILLERS LOG

Date: 7-29, 1963, Driller: Chest Reeves williams County

(Name)

(1) Owner of Land: J.C. Fay  
 (Name)  
Crashy  
 (Address)

(2) Location: 1/4, 1/4, Sec. 5 T3R3  
 Disregard 3 miles N.W., of Crashy  
 (distance) (direction) (Nearest Town)

(3) Topography: Hilly  
 (Hilly) (Flat) (Level)

(4) Purpose of Well: Domestic  
 (Domestic Irrigation  
 Municipal, Industrial, Other)

Description & Color of Materials Sand, Clay, Red Clay, Shell, etc.	Thick-ness Feet	De
clay	35	35
white sand	72	107
<del>COPIED</del>		
Bl. 30' top map		

Information upon completion of well:

(1) Diameter 4 inches.

(2) Total Depth 107 feet.

(3) Water Level 73 feet below top of ground.

(4) Cased to bottom, Size 4"

(5) Screen: Size 4, Length 4'

(6) Were any formations sealed against pollution?  
 \_\_\_\_\_ yes,  no.


*Handwritten notes:*  
 Permit to drill  
 do not allow water to flow  
 T&R  
 Adams  
 John

If YES depth of formation \_\_\_\_\_

Why \_\_\_\_\_

Drillers Remarks: New House

REEVES WELL & PUMP CO.  
 P. O. BOX 71 - BRIDGES, MISSISSIPPI

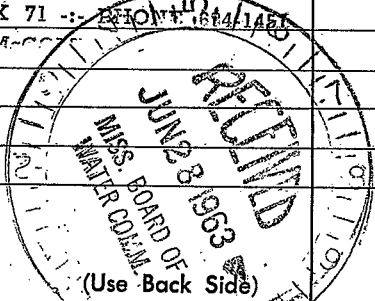

Well No.

