

MISSISSIPPI DEPARTMENT OF NATURAL RESOURCES

Bureau of Land and Water Resources

Southport Mall

P.O. Box 10631

CODED

Jackson, Mississippi 39209

WATER WELL DRILLERS LOG *Wilkinson*

WILKINSON
F 11
4-7-81

4-7 1981
date well completed

81 Rayburn Drilling Adams
firm name

county well located

LANDOWNER:

D & D Drilling

Natchez, Ms.
(drilling address)

WELL LOCATION:

sec. 22 T. 3 N. R. 3 E. S. 5
miles *nw* of *Leslie*
(distance) (direction) (nearest town)

WELL PURPOSE:

(home, irrigation, municipal, industrial)

WELL COMPLETION DATA:

- (1) diameter (inches) 3"
- (2) total depth (feet) 455'
- (3) static water level (feet) 150' below above top of ground.
- (4) casing BVC 455'
(material) (depth)
3" If telescope see back.
(size)
- (5) screen _____
(length) (depth to top)
(size) (material)
- (6) pump 55 MPG
(HP) (yield gpm)
(type power)
- (7) electric log no
(yes or no)
(organization running log)
- (8) how well bottom plugged Wood Plug

description of formations encountered

from

to

Top soil

0

clay

8

shale

90

sand

140

shale

180

sand

330


shale & streaks of sand

380

sand

435

Stalled pipe

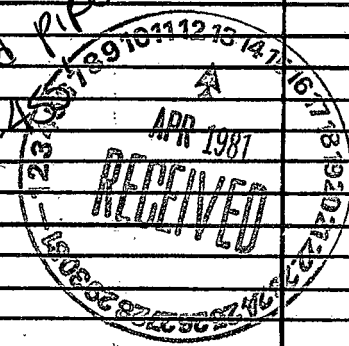

DEPT. OF NATURAL RESOURCES
BUREAU OF LAND & WATER RESOURCES


APR 13 1981

RECEIVED

DRILLERS REMARKS:

If well telescopes please sketch and show depths.

GROUND LEVEL

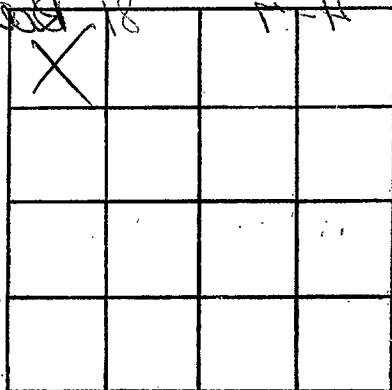

SECTION *22*

Please indicate well location X.

ADDITIONAL INFORMATION

If more than one screen,
show locations of each on sketch.