

MISSISSIPPI DEPARTMENT OF NATURAL RESOURCES
Bureau of Land and Water Resources
 Southport Mall
 P.O. Box 10631
 Jackson, Mississippi 39209
WATER WELL DRILLERS LOG

CODED

Wilkinson
F 12
 7-15-81

7-15 date well completed 1981 *Rayborn Drilling & Compt. Co.* firm name *Wilkinson* county well located

LANDOWNER:
Adco Producing Co.
Hatchey, Ms.
 (mailing address)


description of formations encountered	from	to
<i>Top soil</i>	<i>0</i>	<i>2</i>
<i>Sand & Rec gravel</i>	<i>2</i>	<i>55</i>
<i>Chalk</i>	<i>55</i>	<i>255</i>
<i>Rock</i>	<i>255</i>	<i>256</i>
<i>Shale</i>	<i>256</i>	<i>270</i>
<i>Sand</i>	<i>270</i>	<i>415</i>

WELL LOCATION:
 sec. *35* T. *3*^N S. R. *3* E.
2 miles *N* of *Leslie*
 (distance) (direction) (nearest town)

Fr NW/cor Sec. 35 9a
E 1/4 Sec. L/ 3300' 4th S @
RA 1162' to loc.

WELL PURPOSE:
 (home, irrigation, municipal, industrial)

- WELL COMPLETION DATA:**
- (1) diameter (inches) 3"
 - (2) total depth (feet) 415'
 - (3) static water level (feet) 136 below/above top of ground.
 - (4) casing Blk 395'
 (material) (depth)
3" if telescope see back.
 (size)
 - (5) screen 20' 395'
 (length) (depth to top)
3" Slotted Pipe
 (size) (material)
 - (6) pump _____
 (HP) (yield gpm)
 (type power)
 - (7) electric log NO
 (yes or no)
 (organization running log)
 - (8) how well bottom plugged wood plug

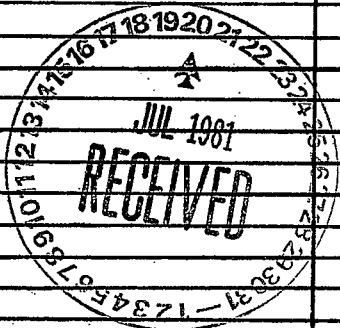


CODED

DRILLERS REMARKS:

If well telescopes please sketch and show depths.

GROUND LEVEL

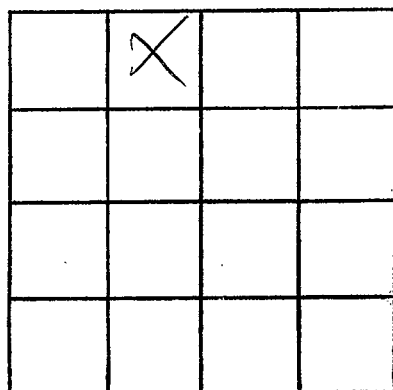

SECTION 35

Please indicate well location X.

ADDITIONAL INFORMATION

If more than one screen,
show locations of each on sketch.