

MISSISSIPPI DEPARTMENT OF NATURAL RESOURCES

Bureau of Land and Water Resources

Southport Mall

P.O. Box 10631

Jackson, Mississippi 39209

WATER WELL DRILLERS LOG

**CODED**

|           |
|-----------|
| Wilkinson |
| F 13      |
| 12-20-81  |

12-20 date well completed      1981 Rayburn Drilling firm name      Wilkinson county well located

LANDOWNER:  
B. H. Fortenberry Dill  
Natchez, Mo. 39120  
 (mailing address)

| description of formations encountered | from       | to         |
|---------------------------------------|------------|------------|
| <u>chalk</u>                          | <u>0</u>   | <u>250</u> |
| <u>sand</u>                           | <u>250</u> | <u>325</u> |

WELL LOCATION: go to city Twp/L 2067  
 sec 2 T 3 N R 3 E 3404  
3 miles SW of Dickinson  
 (distance) (direction) (nearest town)

Fr NE/Cor. Sec. 4, 2<sup>nd</sup> E 1/4  
 Twp/L 2067 2<sup>nd</sup> S E RA 3404  
 to loc in Sec. 2

WELL PURPOSE:  
 (home, irrigation, municipal, industrial)

**CODED**

WELL COMPLETION DATA:

(1) diameter (inches) 3"

(2) total depth (feet) 325

(3) static water level (feet) 100 <sup>below</sup>/<sub>above</sub> top of ground. Dickinson

(4) casing WR, 305'  
 (material) (depth)  
3" if telescope see back.  
 (size)

(5) screen 20, 305'  
 (length) (depth to top)  
3", slotted pipe  
 (size) (material)

(6) pump -, 50  
 (HP) (yield gpm)  
elec.  
 (type power)

(7) electric log -  
 (yes or no)  
 (organization running log)

(8) how well bottom plugged w/lead plug

Dickinson  
Ventrios VPA #1

DEPT. OF NATURAL RESOURCES  
 BUREAU OF LAND & WATER RESOURCES


DEC 28 1981

**RECEIVED**

DRILLERS REMARKS:

If well telescopes please  
sketch and show depths.

GROUND LEVEL

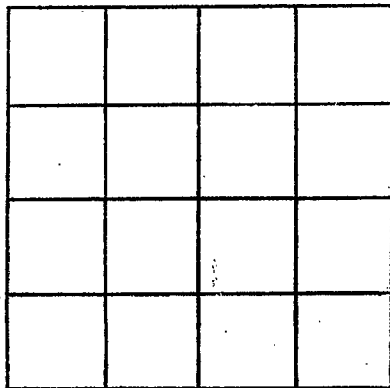

SECTION \_\_\_\_\_

Please indicate well location X.

ADDITIONAL INFORMATION

If more than one screen,  
show locations of each on sketch.