

MISSISSIPPI DEPARTMENT OF NATURAL RESOURCES
 Bureau of Land and Water Resources
 Southport Mall
 P.O. Box 10631
 Jackson, Mississippi 39209
WATER WELL DRILLERS LOG

CODED

Wilkinson
 F14
 12/30/81

12-30-81 date well completed
 Rayborn Drill & Const. firm name
 Wilkinson county well located

LANDOWNER:
 B. J. Jostenberry
 Natchez, Ms.
 (mailing address)

WELL LOCATION:
 sec. 2 T. 30 N. R. 3 E
 8 miles South of Natchez
 (distance) (direction) (nearest town)

WELL PURPOSE:
 (home, irrigation, municipal, industrial)

WELL COMPLETION DATA:

(1) diameter (inches) 2"
 (2) total depth (feet) 305'
 (3) static water level (feet) 15' below top of ground
 (4) casing Blk 285' (material) (depth)
 3" (size) if telescope see back.
 (5) screen 20' (length) 285' (depth to top)
 3" (size) Slotted Pipe (material)
 (6) pump 52 GPM (HP) (yield gpm)
 (type power)
 (7) electric log no (yes or no)
 (organization running log)
 (8) how well bottom plugged wood plug


description of formations encountered	from	to
Top soil	10	30
Chault	30	70
Sand	70	105
Chault	105	215
Sand	215	305
FR NE/COR Sec. 2 SW 1/4 Twp/L 2954, th S E RA 244 40 Loc. in Sec. 2		
Ventress BRB #1 CODED		
DEPT. OF NATURAL RESOURCES BUREAU OF LAND & WATER RESOURCES		
JAN 12 1982		

DRILLERS REMARKS:

RECEIVED

If well telescopes please sketch and show depths.

GROUND LEVEL

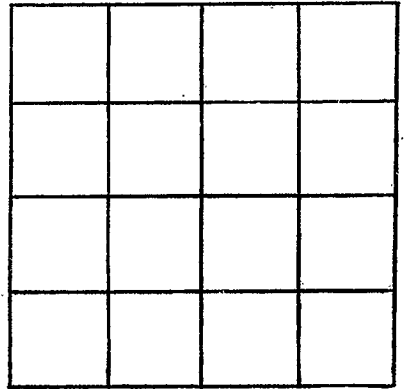

SECTION _____

Please indicate well location X.

ADDITIONAL INFORMATION

If more than one screen,
show locations of each on sketch.