

MISSISSIPPI DEPARTMENT OF NATURAL RESOURCES

Bureau of Land and Water Resources

Southport Mall

P.O. Box 10631

Jackson, Mississippi 39209

WATER WELL DRILLERS LOG

CODED

WELKINSON  
F 15  
2-12-82  
2-13 1982  
 date well completed

Rayburn Drilling Welkinson  
 firm name county well located

LANDOWNER:  
Wilcox Drillers  
Natchez, Mo  
 (mailing address)

description of formations encountered	from	to
<u>top soil</u>	<u>0</u>	<u>6</u>
<u>chalk</u>	<u>6</u>	<u>50'</u>
<u>gumbo</u>	<u>50'</u>	<u>110'</u>
<u>sand</u>	<u>110'</u>	<u>210'</u>
<u>gumbo</u>	<u>210'</u>	<u>330'</u>
<u>sand</u>	<u>330'</u>	<u>430'</u>

WELL LOCATION:  
 sec. 34 T. 30 N. R. 3 E.  
1 1/2 miles NW of Lanehart  
 (distance) (direction) (nearest town)

WELL PURPOSE:  
 (home, irrigation, municipal, industrial)

WELL COMPLETION DATA:

(1) diameter (inches) 3"

(2) total depth (feet) 430'

(3) static water level (feet) 150' below above top of ground.

(4) casing hbk 410'  
 (material) (depth)

3" if telescope see back.  
 (size)

(5) screen 20' 410'  
 (length) (depth to top)

3" slotted pipe  
 (size) (material)

(6) pump — 50  
 (HP) (yield gpm)

elec.  
 (type power)

(7) electric log —  
 (yes or no)

(organization running log)

(8) how well bottom plugged wood plug

Sections # 1

CODED

CODED

gauge w/ 2602' H dial  
w/ 8:30' to loc.

DEPT. OF NATURAL RESOURCES  
 BUREAU OF LAND & WATER RESOURCES


MAR - 8 1982

DRILLERS REMARKS:

RECEIVED

If well telescopes please  
sketch and show depths.

GROUND LEVEL

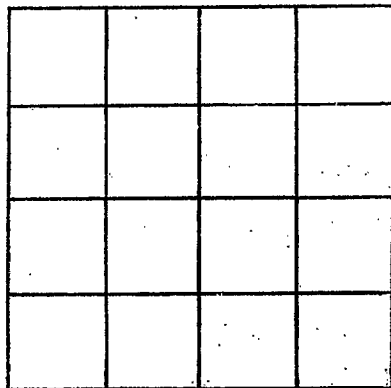

SECTION \_\_\_\_\_

Please indicate well location X.

ADDITIONAL INFORMATION

If more than one screen,  
show locations of each on sketch.