

MISSISSIPPI DEPARTMENT OF NATURAL RESOURCES

Bureau of Land and Water Resources

Southport Mall

P.O. Box 10631

Jackson, Mississippi 39209

WATER WELL DRILLERS LOG

CODED

WILKINSON
 F16
 9/19/83

9/19/1983 Rayburn Drilling Co. Inc. West. Wilkino.
 date well completed firm name county well located

LANDOWNER:
Shamrock Drilling
Natchez, Miss.
 (mailing address)

description of formations encountered	from	to
<u>Top Soil</u>	<u>0</u>	<u>2</u>
<u>Clay</u>	<u>3</u>	<u>140</u>
<u>Sand</u>	<u>141</u>	<u>160</u>
<u>Clay</u>	<u>161</u>	<u>300</u>
<u>Sand</u>	<u>301</u>	<u>370</u>

WELL LOCATION:
~~2323~~ 30 T 30 N R 2 E
20 miles South of Buffalo
 (distance) (direction) (nearest town)

WELL PURPOSE: oil field
 (home, irrigation, municipal, industrial)

WELL COMPLETION DATA:

(1) diameter (inches) 3"

(2) total depth (feet) 370'

(3) static water level (feet) 185' below top of ground.

(4) casing 3' Blk, 350'
 (material) (depth)
3" if telescope see back.
 (size)

(5) screen 20', 350'
 (length) (depth to top)
3", Blk
 (size) (material)

(6) pump —, 50
 (HP) (yield gpm)
—
 (type power)

(7) electric log —
 (yes or no)
—
 (organization running log)

CODED

33-17 45A

1029' N E 1689' W by SR/107

(8) how well bottom plugged used plug

DRILLERS REMARKS:


DEPT. OF NATURAL RESOURCES
 BUREAU OF LAND & WATER RESOURCES

NOV 28 1983

RECEIVED

If well telescopes please sketch and show depths.

GROUND LEVEL

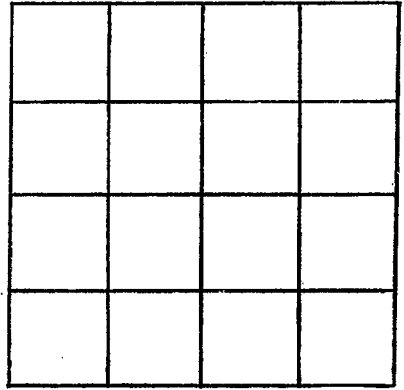

SECTION _____

Please indicate well location X.

ADDITIONAL INFORMATION

If more than one screen,
show locations of each on sketch.