

MISSISSIPPI DEPARTMENT OF NATURAL RESOURCES

Bureau of Land and Water Resources

Southport Mall

P.O. Box 10631

Jackson, Mississippi 39209

WATER WELL DRILLERS LOG

CODED

WILKINSON
F 17

7/6 1976 date well completed 84 Rayborn Drilling firm name Wilkinson county well located

LANDOWNER:	description of formations encountered	from	to
Shamrock Drilling	Top Soil	0	4
Natchez, ms (mailing address)	Chalk	5	20
WELL LOCATION:	Sand	21	50
sec. 12 T. 30N R. 3E	Chalk	51	60
2 miles west of Debroso	Sand	101	110
(distance) (direction) (nearest town)			

WELL PURPOSE: oil field
(home, irrigation, municipal, industrial)

- WELL COMPLETION DATA:
- (1) diameter (inches) 3"
 - (2) total depth (feet) 110'
 - (3) static water level (feet) 15' below above top of ground.
 - (4) casing bk pipe, 50'
(material) (depth)
3" if telescope see back.
(size)
 - (5) screen 20', 50'
(length) (depth to top)
3", slotted pipe
(size) (material)
 - (6) pump —, 50
(HP) (yield gpm)
—
(type power)
 - (7) electric log no
(yes or no)
—
(organization running log)
 - (8) how well bottom plugged wood

Special Name: Wentress 12-1


DEPT. OF NATURAL RESOURCES
BUREAU OF LAND & WATER RESOURCES

OCT 31 1964
RECEIVED

DRILLERS REMARKS:

If well telescopes please sketch and show depths.

GROUND LEVEL

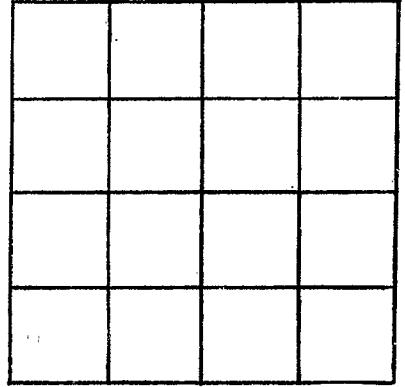

SECTION _____

Please indicate well location X.

ADDITIONAL INFORMATION

If more than one screen,
show locations of each on sketch.