

MISSISSIPPI DEPARTMENT OF NATURAL RESOURCES

Bureau of Land and Water Resources

Southport Mall

P.O. Box 10631

Jackson, Mississippi 39209

WATER WELL DRILLERS LOG

CODED

WILKINSON
F18

7/16/1984 date well completed 84 Rayborn Drilling firm name Wilkinson county well located

LANDOWNER:
Shamrock Drilling
Natchez, ms 39120
(mailing address)

description of formations encountered	from	to
Top Soil	0	15
Clay	16	85
Sand	86	100
Gumbo	101	250
Streak Sand	251	315
Sand	316	340

WELL LOCATION:
sec. 12 T. 3^N R. 3^E
2 miles W of Dorso
(distance) (direction) (nearest town)

WELL PURPOSE: oil field
(home, irrigation, municipal, industrial)

- WELL COMPLETION DATA:
- (1) diameter (inches) 3"
 - (2) total depth (feet) 340'
 - (3) static water level (feet) 150' below top of ground.
 - (4) casing blk pipe, 320' (material) (depth)
3" (size) if telescope see back.
 - (5) screen 20' 320' (length) (depth to top)
3" (size) slotted pipe (material)
 - (6) pump (HP) 50 (yield gpm)
 - (7) electric log NO (yes or no)
(organization running log)
 - (8) how well bottom plugged wood

Well Name:
Ventress 12-1


CODED

RECEIVED
OCT 27 1984
DEPT. OF NATURAL RESOURCES
BUREAU OF LAND & WATER RESOURCES

DRILLERS REMARKS:

If well telescopes please
sketch and show depths.

GROUND LEVEL

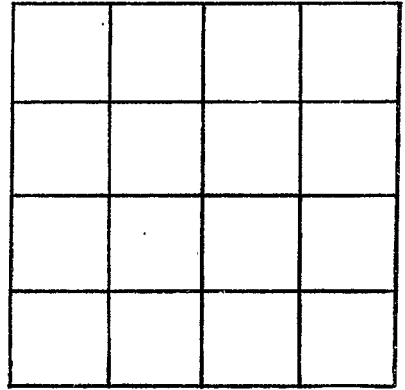

SECTION _____

Please indicate well location X.

ADDITIONAL INFORMATION

If more than one screen,
show locations of each on sketch.