

MISSISSIPPI DEPARTMENT OF NATURAL RESOURCES

Bureau of Land and Water Resources

Southport Mall

P.O. Box 10631

Jackson, Mississippi 39209

WATER WELL DRILLERS LOG

CODED

WILKINSON
F19

7/13 1984 Raybom Drilling Wilkinson
date well completed firm name county well located

LANDOWNER:
Shamrock Drilling
Natchez, ms
(mailing address)

description of formations encountered	from	to
Top Soil	0	6
Gumbo	7	58
Shale	59	110
Break sand	111	170
sand	171	201

WELL LOCATION:
sec. 13 T. 30 N. R. 3 E. S. 6
6 miles North of Natchez, ms
(distance) (direction) (nearest town)

WELL PURPOSE: oil field
(home, irrigation, municipal, industrial)

WELL COMPLETION DATA:

(1) diameter (inches) 3"

(2) total depth (feet) 201'

(3) static water level (feet) _____ below/above top of ground.

(4) casing HP pipe, 181'
(material) (depth)
3" (size) If telescope see back.

(5) screen 20', 181'
(length) (depth to top)
3" (size) Slotted pipe (material)

(6) pump _____ (HP) 50 (yield gpm)

(7) electric log no (yes or no)
(organization running log)

(8) how well bottom plugged wood

CODED

Lease Name:
Wentress 13-1
FR SW/4 SEC 13N - 3W 90
WB 4', TH S 3718' to 200


DRILLERS REMARKS:

DEPT. OF NATURAL RESOURCES
BUREAU OF LAND & WATER RESOURCES

OCT 31 1984
RECEIVED

If well telescopes please
sketch and show depths.

GROUND LEVEL

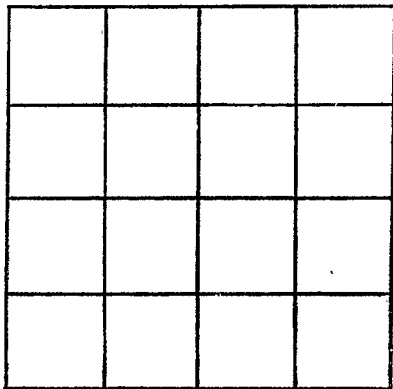

SECTION _____

Please indicate well location X.

ADDITIONAL INFORMATION

If more than one screen,
show locations of each on sketch.