

MISSISSIPPI DEPARTMENT OF NATURAL RESOURCES

Bureau of Land and Water Resources

Southport Mall

P.O. Box 10631

Jackson, Mississippi 39209

WATER WELL DRILLERS LOG

CODED

WILKINSON
F020

9/3 1985 Rayborn Drig Co. Wilkinson
date well completed firm name county well located

LANDOWNER: <u>D & O Drig Co.</u>	description of formations encountered	from	to
<u>PO Box 351</u>			
<u>Ferriday LA 71334</u> (mailing address)	<u>Sand</u>	<u>15</u>	<u>95</u>
WELL LOCATION:			
sec. <u>10</u> T. <u>3</u> (N) S R. <u>3</u> E (W)			
<u>6</u> miles <u>SW</u> of <u>Doloroso</u> (distance) (direction) (nearest town)			
WELL PURPOSE: <u>oilfield</u> (home, irrigation, municipal, industrial)			
WELL COMPLETION DATA:			
(1) diameter (inches) <u>3"</u>			
(2) total depth (feet) <u>95'</u>			
(3) static water level (feet) <u>40'</u> <u>below</u> top of ground. <u>above</u>			
(4) casing <u>PVC Pipe, 85'</u> (material) (depth) <u>3"</u> (size) If telescope see back.			
(5) screen <u>10'</u> (length) <u>85'</u> (depth to top) <u>3"</u> (size) <u>PVC Slotted Pipe</u> (material)			
(6) pump <u>—</u> (HP) <u>50</u> (yield gpm)			
(7) electric log <u>no</u> (yes or no)			
(8) how well bottom plugged <u>wood</u>			
DRILLERS REMARKS:			

336° N & 459° E of SW corner


Well Name: Pettis Heirs WP # 1

APR - 8 1985

Department of Natural Resources
Bureau of Land and Water Resources

If well telescopes please
sketch and show depths.

GROUND LEVEL

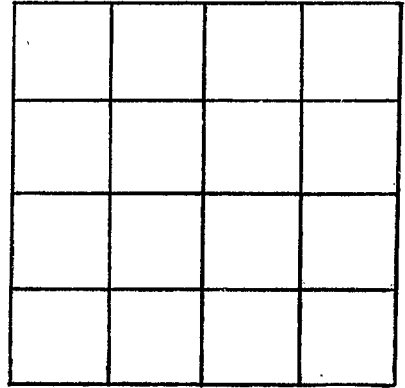

SECTION _____

Please indicate well location X.

ADDITIONAL INFORMATION

If more than one screen,
show locations of each on sketch.