| County: NIKINSON |
|----------------------------------|
| Permit #: Driller: Gary Rayborn |
| Date drilling completed: 5/14/13 |

State Well Report

Part 1

Mississippi Department of Environmental Quality
Office of Land and Water Resources
P.O. Box 10631
Jackson, MS 39289-0631
(601)961-5210
(601)354-6938 (fax)

| For Office Use Only: |
|----------------------|
| Aquifer: |
| Well #: |
| L. S. Elevation: |
| E-log #: |

State Law requires that this report be prepared by the driller in detail and filed with the Department within 30 days of completion of drilling of the well.


| 30 days of completion of drilling of the well. | | | |
|-----------------------------------------------------------------------------------------------------------------------------------|-------------------------------------------------------------------------------------------------------------------------------------------------------------------------------------------------------------------------------------------------------------------------------------------------------------------------------------------------------------------------------------------------------------------------------------------------------------------------------------------------------------------------------------------------------------------------------------------------------------------------------------------------------------------------------------------------------------------------------------------------------------------------------------------------------------------------------------------------------------------------------------------------------------------------------------------------------------------------------------------------------------------------------------------------------------------------------------------------------------------------------------------------------------------------------------------------------------------------------------------------------------------------------------------------------------------------------------------------------------------------------------------------------------------------------------------------------------------------------------------------------------------------------------------------------------------------------------------------------------------------------------------------------------------------------------------------------------------------------------------------------------------------------------------------------------------------------------------------------------------------------------------------------------------------------------------------------------------------------------------------------------------------------------------------------------------------------------------------------------------------------|--|--|
| Well Owner Information | Well Location 49 | | |
| Owner Name Dan Brown | Latitude: 31.11.10 " Longitude: 91.27.58" | | |
| Mailing Address: P.O.Box 800 | Method of Lat/Long (circle one): Conventional Survey, | | |
| | USGS quad, Hand-held GPS, Survey-grade GPS | | |
| St Francis Ville, LA 7075 City State Zip Code | 1R 1/4 1R 1/4 Sec 37 V Twn 3N Rng 3W | | |
| City State / Zip Code Telephone No. () | Distance Direction Nearest Town 4.1 Miles NW of Lessley, US | | |
| XX.11 T | | | |
| Well I | Jata | | |
| Purpose of Well (circle one Home Industrial Public Supply | Irrigation Fish Culture Other: | | |
| Date well drilling started: 51413 Date well drilling completed: 51413 | | | |
| If flowing, method of flow regulation: Valve Other (describe) | | | |
| Static Water Level: 40 feet above or below circle one) 1 | and surface Date measured: 5/14/13 | | |
| Method of Measurement (circle one) steel tape electric tape | air line other: | | |
| Hole depth: 205 / Well depth: 205 / Well grouted to a depth of 10 feet | | | |
| Type of grout (circle one). Cement Bentonite Mix | | | |
| Casing length: 185 feet Casing diameter: 4 inches Type of casing: PUC | | | |
| Screen length: 20feet Screen diameter: 4inches Type of screen: PVC | | | |
| Screen slot size: 1010 inches Setting depth: From 185 feet to 205 feet | | | |
| Type of completion (circle all applicable). Gravel packed Underreamed Telescoped Open hole Natural Development | | | |
| Other (describe): | | | |
| Top of lap pipe or reduction in casing: feet. If telescoped or more than one screen, describe on back of page | | | |
| Logs run (circle all applicable): No log run Electric Gamma Ray | Density Sonic Neutron Other: | | |
| Name of organization running log(s): | | | |
| I certify that the well was drilled, constructed, and completed in accordance with all applicable requirements of the Mississippi | | | |
| Department of Environmental Quality and/or the Mississippi Department of Health regulations and state laws. | | | |
| RAYBORN DRILLING INC. 0-60 | A CONTRACT OF THE PROPERTY OF | | |
| Print Name of Water Well Contractor and License No. | Signature of Water Well Con Rate CEIVE | | |

MAY 24 2013

Ground Level

| Description of Formations Encountered | From | To |
|---------------------------------------|-------------|-------------|
| | | |
| CHALK | 10 | 160 |
| CITIEN | - | 100 |
| | 100 | 7- |
| SAND | 160 | 000 |
| | | |
| | | |
| | | |
| | | |
| | | 1 |
| | | |
| | | |
| | | \vdash |
| | | |
| | | |
| | | |
| | | |

If more than one screen, show location of each on sketch

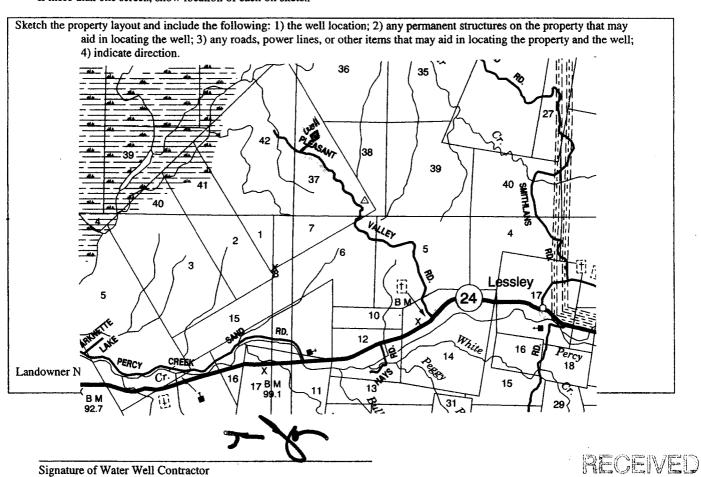

MAY 3 4 2010

BY: OLWR

STATE WELL REPORT

Part 2

(601)961-5210

(601)354-6938 (fax)

Pump Installer's Completion Report Mississippi Department of Environmental Quality Office of Land and Water Resources P.O. Box 10631 Jackson, MS 39289-0631

Date completed:

RAYBORN DRILLING, INC.

Print Name of Pump Installer and License No. (if applicable)

For Office Use Only: Aquifer: Well #: Elevation:

| This report should be prepared by the pump installer in detail and filed with the Department within 30 days of the installation of pump. | | | |
|------------------------------------------------------------------------------------------------------------------------------------------|-------------------------------------------------------------------------------------------|--|--|
| Well Owner Information | Well Location | | |
| Owner Name: Dan Brown | Latitude: 31° 11′ 10″ Longitude: 91° 27′ 58″ | | |
| Mailing Address: | Method of Lat/Long (circle one): Conventional Survey, | | |
| P.O. Box 800 | USGS quad, Hand-held GPS, Survey-grade GPS | | |
| | · | | |
| St Francis Ville LA 70TD) | $\frac{1}{4}$ $\frac{1}{4}$ Sec $\frac{37}{1}$ Twn $\frac{3N}{1}$ Rng $\frac{3\omega}{1}$ | | |
| City State Zip Code | | | |
| | Distance Direction Nearest Town | | |
| The land on Mary | 4.1 Miles NW of Lessley, MS | | |
| Telephone No. () | Tri Miles No or 2051241. | | |
| | <u></u> | | |
| Pump Type | Power Type | | |
| Circle one | Circle one | | |
| | | | |
| Air Lift Jet Submersible | Diesel Engine Gasoline Engine Natural Gas | | |
| Bucket Piston Turbine | Electric Motor Hand Tractor PTO | | |
| Bucket Piston Turbine | Electric Motor Haild Hactor FTO | | |
| Centrifugal Rotary Flowing Well | Windmill Other (specify): | | |
| | Horse Power Rating of Motor: | | |
| Other (specify): | | | |
| Date Pump Installed: 5/14/13 | Setting Depth: 'OO feet | | |
| _ | . 101 | | |
| Rated Pump Capacity:Gallons Per Minute | Number of Stages: | | |
| | | | |
| Punap Test Data | Method of Measuring Water Level | | |
| | Circle one | | |
| Date Well Tested: 51413 | | | |
| \mathcal{A}_{\wedge} | Air Line Electric Measuring Line Steel Tape | | |
| Static Water Level (A): Feet Below Land Surface | | | |
| Pumping Water Level (B):Feet Below Land Surface | Other (specify): | | |
| rumping water Level (b)reet below Land Surface | | | |
| Drawdown [(B) - (A)]:Feet Below Land Surface | For flowing well, measured shut in head:feet | | |
| Test Pumping Rate:Gallons Per Minute | Well yielded GPM with a drawdown of | | |
| Joni I winping I was Smions I of Printed | | | |
| Duration of Pump Test (minimum 4 hours):hours | feet afterhours of pumping | | |
| | | | |
| | | | |
| A MEDITAL CIDATES A LA L | 6 mm lm and adm | | |
| I HEREBY CERTIFY that the above statements are true to the best o | r my knowledge. | | |
| RAYBORN DRILLING, INC. 0-60 | XDECEN/ED | | |

MAY 2 4 2013

Signature of Pump Installer