

WILKINSON
F 2000
10-12-76

MISSISSIPPI
 BOARD OF WATER COMMISSIONERS
 416 North State Street
 Jackson, Mississippi 39201

WATER WELL DRILLERS LOG

10-12 1976 Rayburn Drilling & Const Co. Wilkerson
 date well completed firm name county well located

LANDOWNER:
Robert Lee Hunt
Woodville, Miss.
 (mailing address)

description of formations encountered	from	to
<u>Top Soil</u>	<u>0</u>	<u>2</u>
<u>red clay</u>	<u>2</u>	<u>4</u>
<u>grey clay</u>	<u>4</u>	<u>220</u>
<u>limestone</u>	<u>220</u>	<u>250</u>
<u>blue clay</u>	<u>250</u>	<u>380</u>
<u>Sand</u>	<u>380</u>	<u>420</u>

WELL LOCATION:
 sec. 36 T. 3 N. R. 3 E.
2 1/2 miles N of Desha
 (distance) (direction) (nearest town)

WELL PURPOSE: Home
 (home, irrigation, municipal, industrial)

- WELL COMPLETION DATA:
- (1) diameter (inches) 2"
 - (2) total depth (feet) 420'
 - (3) static water level (feet) 157' below top of ground.
 - (4) casing galv. 413'
 (material) (depth)
2" if telescope see back.
 (size)
 - (5) screen 5' 413'
 (length) (depth to top)
2" 155"
 (size) (material)
 - (6) pump 2 66gpm
 (HP) (yield gpm)
elec.
 (type power)
 - (7) electric log no.
 (yes or no)
 - (8) how well bottom plugged wood plug


DRILLERS REMARKS:

RECEIVED
 FEB 10 1977

MISS. BB. OF WATER COMMISSIONERS

If well telescopes please sketch and show depths.

GROUND LEVEL

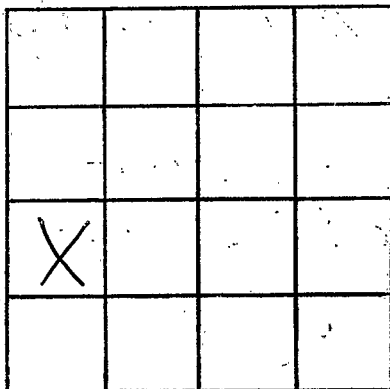

SECTION 26

Please indicate well location X.

ADDITIONAL INFORMATION

If more than one screen,
show locations of each on sketch.