

WILKINSON
WILKINSON

F

2001

10/15/77

MISSISSIPPI
BOARD OF WATER COMMISSIONERS
416 North State Street
Jackson, Mississippi 39201

WATER WELL DRILLERS LOG

Wilkinson

10-15
date well completed

19 77 Rayburn Drill. & Cond. Co.
firm name

Jackson
county well located

LANDOWNER:

Buck Island Hunting Club

(mailing address)

description of formations encountered

Top soil

from

to

0 2

grey clay

2 30

sand

30 147

WELL LOCATION:

sec. *7* T. *33* N. R. *3* E.
6 miles *SW* of *Dobson*
(distance) (direction) (nearest town)

WELL PURPOSE: *Home*
(home, irrigation, municipal, industrial)

WELL COMPLETION DATA:

- (1) diameter (inches) *2"*
- (2) total depth (feet) *147'*
- (3) static water level (feet) *20'* below above
top of ground.
- (4) casing *PVC* *140'*
(material) (depth)
2"
(size) If telescope see back.
- (5) screen *5'* *140'*
(length) (depth to top)
2" *"SS"*
(size) (material)
- (6) pump *1/2* *56 gpm*
(HP) (yield gpm)
elec
(type power)
- (7) electric log *no*
(yes or no)

(organization running log)

(8) how well bottom plugged *wood plug*


DRILLERS REMARKS:

RECEIVED

APR 20 1978

If well telescopes please sketch and show depths.

GROUND LEVEL

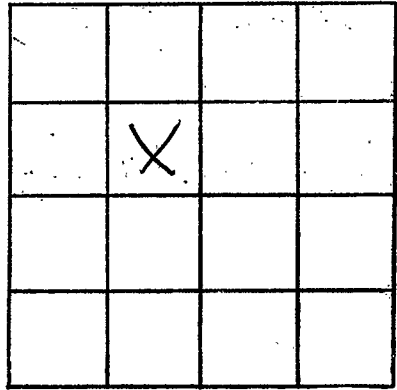

SECTION 7

Please indicate well location X.

ADDITIONAL INFORMATION

If more than one screen,
show locations of each on sketch.