

MISSISSIPPI DEPARTMENT OF NATURAL RESOURCES

Bureau of Land and Water Resources

Southport Mall

P.O. Box 10631

Jackson, Mississippi 39209

WATER WELL DRILLERS LOG

Wilkinson
F
2003

Oct-9

date well completed

19 87 Reenswell Sec. wilkinson

firm name

county well located

LANDOWNER:

Jimmy Session
Woodville
(mailing address)

description of formations encountered

from

to

Hard Clay	0	30
Red Chalky sand	30	87
Red Clay Chalk	87	110
Sand + Red Gravel	110	141

WELL LOCATION:

sec. 46 T 3 N R 3 E
7 1/2 miles N-NW of Woodville
(distance) (direction) (nearest town)

WELL PURPOSE:

Farm
(home, irrigation, municipal, industrial)

WELL COMPLETION DATA:

- (1) diameter (inches) 4"
- (2) total depth (feet) 141'
- (3) static water level (feet) 76' below top of ground
- (4) casing plastic bottom
(material) (depth)
- (5) screen 5' 136'
(length) (depth to top)
4" plastic
(size) (material)
- (6) pump 1/2 HP 10
(HP) (yield gpm)
elec
(type power)
- (7) electric log no
(yes or no)

(organization running log)

- (8) how well bottom plugged
rock wash

DRILLERS REMARKS:


DEPT. OF NATURAL RESOURCES
BUREAU OF LAND & WATER RESOURCES

JUN 15 1982

RECEIVED

If well telescopes please
sketch and show depths.

GROUND LEVEL

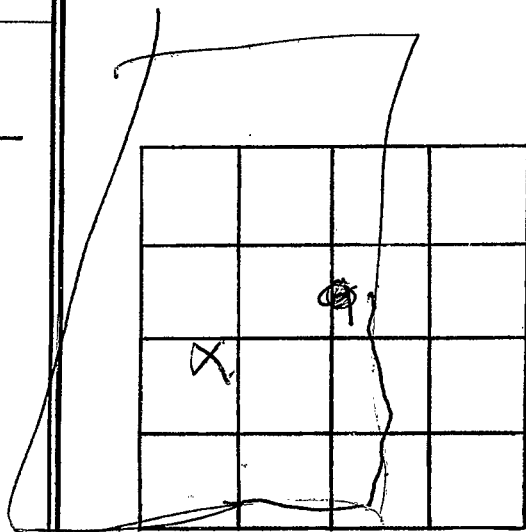

SECTION 46

Please indicate well location X.

ADDITIONAL INFORMATION

If more than one screen,
show locations of each on sketch.