

MISSISSIPPI DEPARTMENT OF NATURAL RESOURCES
Bureau of Land and Water Resources
 Southport Mall
 P.O. Box 10631
 Jackson, Mississippi 39209
WATER WELL DRILLERS LOG

Wilheson
F
2004

11-22-03

1-13 1983 Rayson Drilling & Const. Co., LLC
 date well completed firm name county well located

LANDOWNER:
Shamrock Drilling
Natchez, Ms.
 (mailing address)

description of formations encountered	from	to
<i>Top soil</i>	<i>0</i>	<i>2</i>
<i>gumbo</i>	<i>2</i>	<i>25</i>
<i>sand</i>	<i>25</i>	<i>40</i>
<i>gumbo</i>	<i>40</i>	<i>150</i>
<i>sand</i>	<i>150</i>	<i>180</i>

WELL LOCATION:
 sec. 15 T. 3 S. R. 3 W.
 (distance) miles (direction) of (nearest town)

WELL PURPOSE:
 (home, irrigation, municipal, industrial)

- WELL COMPLETION DATA:**
- (1) diameter (inches) 3"
 - (2) total depth (feet) 180'
 - (3) static water level (feet) 30' below above top of ground.
 - (4) casing PVC, 160'
 (material) (depth)
3"
 (size) if telescope see back.
 - (5) screen 20', 160'
 (length) (depth to top)
3", slotted Pipe
 (size) (material)
 - (6) pump —, 52Gpm
 (HP) (yield gpm)
—
 (type power)
 - (7) electric log no
 (yes or no)
 - (8) how well bottom plugged Wood Plug

3"

180'

30'

PVC, *160'*

3"

20', *160'*

3", *slotted Pipe*

52Gpm

no


Wood Plug

DRILLERS REMARKS:

DEPT. OF NATURAL RESOURCES
 BUREAU OF LAND & WATER RESOURCES
 FEB 22 1983
RECEIVED

If well telescopes please
sketch and show depths.

GROUND LEVEL

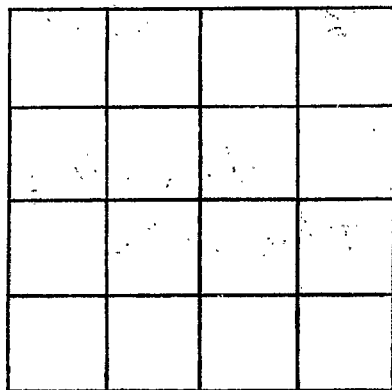

SECTION _____

Please indicate well location X.

ADDITIONAL INFORMATION

If more than one screen,
show locations of each on sketch.