

MISSISSIPPI DEPARTMENT OF ENVIRONMENTAL

QUALITY

Office of Land and Water Resources

COUNTY WELL LOCATED
WALTON
 WELL NUMBER **F 2010**
 CODED
 DATE WELL COMPLETED
3-11-98

PERMIT NUMBER
0-287
 NAME OF DRILLING FIRM
Reever Well Ser.

P. O. Box 10631
Jackson, MS 39289-0631
WATER WELL DRILLERS LOG

NAME & MAILING ADDRESS OF LANDOWNER
Jimmy Session

PUMP DATA

PUMP TYPE (Circle One):
 Submersible Turbine Jet Flowing Well,
 Other (Describe) _____
 POWER TYPE (Circle One):
 Electric Tractor Diesel Gasoline Butane,
 Other (Describe) _____
 H/P 1

WELL LOCATION: SEC TOWNSHIP RANGE
 43 **3** **3**
 S **E**

Pump Capacity (GPM) No. of Stages Setting Depth
10 **11** **150** FT.

DISTANCE DIRECTION NEAREST TOWN
6 Miles **N** of **Woodville**

PUMP TEST
 Well yielded **40** GPM with
 a drawdown of **10** ft.
 after **1** hours of pumping

OTHER LANDMARK
HOME

WELL PURPOSE: Home, Irrigation, Municipal, Industrial, Fish Pond, etc.

LOG DATA

TYPE OF LOG RUN (Circle One): No Log Run,
 Electric, Gamma Ray, Density, Sonic, Neutron,
 Other (Describe) _____
 Name of Organization Running Log

WELL DATA

Well Depth 160'	Casing Diameter (In.) 4"	Casing Length (Ft.) 20'
Type of Casing PVC	Hole Depth 160'	Depth to Static Water Level 120'

GEOLOGIC DATA (Office Use Only)

Surface Elev.	Geologic Unit	Unit Thickness	Depth to Top
Subs. SWL	Date	Analysis	Aquifer Test

TYPE OF COMPLETION: (Circle One or More):
 Gravel Packed, Underreamed, Telescoped,
 Natural Development, Open Hole, Other
 (Describe) **10 gal sand**

WELL GROUTED TO A DEPTH OF **10** FEET
 Type Grout (circle one): Cement, Bentonite, or Mix

Driller's Remarks

Top of Lap Pipe or Reduction in Casing

FEET IF TELESOPED OR MORE THAN ONE SCREEN: USE BACK PAGE

SCREEN DATA

Diameter - Inches 4"	Length - Feet 10'	Slot Size - Inches 10 THDS.
Screen Type PVC	Depth to Bottom - Feet 160'	


DESCRIPTION OF FORMATIONS ENCOUNTERED	FROM	TO	FORMATIONS (Continued)	FROM	TO
Clay	0	5			
sand	5	60			
Chalk	60	120			
coarse sand	120	160			

06 23 98A09:38 RCV

IF MORE SPACE IS NEEDED, USE BACK

If well telescopes please sketch and show depths.

GROUND LEVEL

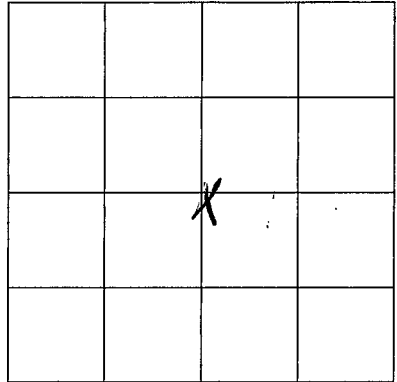

SECTION 43

Please indicate well location X.

ADDITIONAL INFORMATION

Lined area for additional information.

If more than one screen, show location of each on sketch.