

WILK.

G2

CODED

WATER WELL DRILLERS LOG

~~G~~ 301

9-17-60

Date: 9-17, 1960, Driller: Herring Service County Franklin ^{Wilson}

Name

(1) Owner of Land: Milton D. Weather
(Name)

Description & Color of Materials
Sand, Clay, Red Clay, Shell, etc.

Thick-
ness
Feet

Depth
Feet

Rt. 1, Box 831 Woodville, Miss
(Address)

Red Clay
SAND

5'
65' 70'

(2) Location: 1/4, 1/4, Sec. 41 T3 R2W

7 miles North, of Woodville
(distance) (direction) (Nearest Town)

(3) Topography: (Level)
(Hilly) (Flat)

(4) Purpose of Well: Domestic
(Domestic Irrigation, Municipal, Industrial, Other)

Information upon completion of well:

(1) Diameter 4 3/4" inches.

(2) Total Depth 70' feet.

(3) Water Level 20' feet below top of ground.

(4) Cased to 65', Size 2"

(5) Screen: Size 2", Length 5'

(6) Were any formations sealed against pollution?


no

If YES depth of formation

Why

Drillers Remarks:

CODED

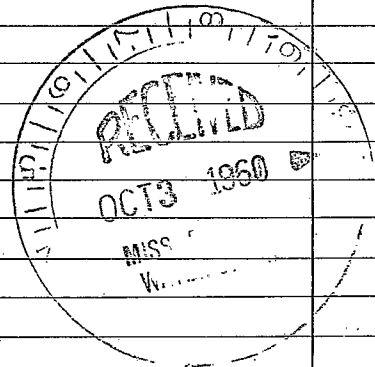

(Use Back Side)

Well No.

