

CODED

Wilkinson  
G 5  
11-19-68

MISSISSIPPI  
BOARD OF WATER COMMISSIONERS  
416 North State Street  
Jackson, Mississippi 39201

WATER WELL DRILLERS LOG

Nov. 19 1968 Renew Well & Pump Wilkinson  
date well completed firm name county well located

LANDOWNER: Paul Davis  
Rt-1-B  
Woodville  
(mailing address)

| description of formations encountered | from | to  |
|---------------------------------------|------|-----|
| white chalk                           | 0    | 27  |
| fine white sand                       | 27   | 33  |
| blue chalk                            | 33   | 111 |
| fine sand                             | 111  | 133 |
| coarse sand & sea gravel              | 133  | 141 |

WELL LOCATION:  
sec 51 T 3 N R 27E  
5 miles N of Woodville  
(distance) (direction) (nearest town)

WELL PURPOSE: Home  
(home, irrigation, municipal, industrial)

- WELL COMPLETION DATA:
- (1) diameter (inches) 4"
  - (2) total depth (feet) 141
  - (3) static water level (feet) 52 below above top of ground.
  - (4) casing Plastic bathtubs  
(material) (depth)
  - (size) if telescope see back.
  - (5) screen 6' 135  
(length) (depth to top)
  - 4" plastic  
(size) (material)
  - (6) pump 10  
(HP) (yield gpm)
  - Electric  
(type power)
  - (7) electric log No  
(yes or no)

(organization running log)

(8) how well bottom plugged wooden plug


DRILLERS REMARKS:  
old well no good

DEC 18 1968

MISS. BD. OF  
WATER COMMISSIONERS

If well telescopes please sketch and show depths.

GROUND LEVEL

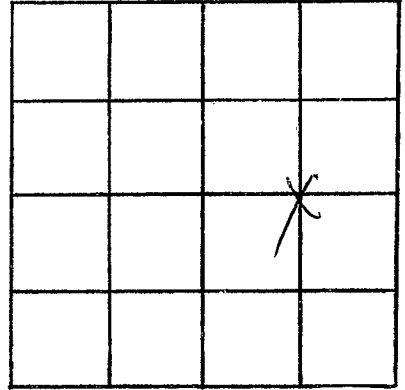

SECTION 51

Please indicate well location X.

ADDITIONAL INFORMATION

If more than one screen,  
show locations of each on sketch.