

Albert

Wilkinson  
 GB  
 3-18-70

MISSISSIPPI  
 BOARD OF WATER COMMISSIONERS  
 416 North State Street  
 Jackson, Mississippi 39201

CODED

WATER WELL DRILLERS LOG

3-18 date well completed 19 70 Heimer Water Well Co. firm name Wilkinson county well located

LANDOWNER:  
 Samuel Nardin  
 Rt 1 Box 330  
 Woodville, Miss.  
 (mailing address)

description of formations encountered	from	to
Top Soil	0	3
Clay	3	66
Sand	66	112

WELL LOCATION:  
 sec. 40 T-3 N R-2 E  
 S W  
 8 miles N of Woodville  
 (distance) (direction) (nearest town)

WELL PURPOSE: Home  
 (home, irrigation, municipal, industrial)

WELL COMPLETION DATA:

(1) diameter (inches) 2"

(2) total depth (feet) 112'

(3) static water level (feet) 97' below above top of ground.

(4) casing Galv. 105' (material) (depth)  
 2" (size) if telescope see back.

(5) screen 5' 105' (length) (depth to top)  
 2" (size) SS. (material)

(6) pump 1/2 5 GPM (HP) (yield gpm)  
 electric (type power)

(7) electric log no. (yes or no)

CODED

(organization running log)


(8) how well bottom plugged Wood

APR 21 1970

DRILLERS REMARKS:

If well telescopes please sketch and show depths.

GROUND LEVEL

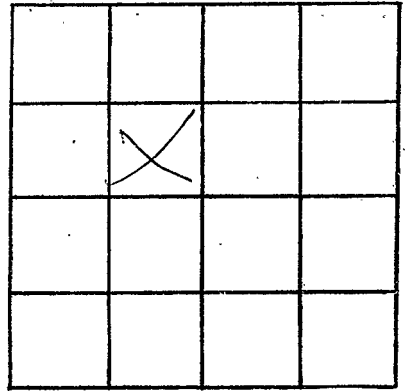

SECTION 40

Please indicate well location X.

ADDITIONAL INFORMATION

If more than one screen, show locations of each on sketch.