

WILKINSON
G9
11-18-70

MISSISSIPPI
BOARD OF WATER COMMISSIONERS
416 North State Street
Jackson, Mississippi 39201

CODED

WATER WELL DRILLERS LOG

11-18 1970 Home Water Well Dr Williamson
date well completed firm name county well located

LANDOWNER:	description of formations encountered	from	to
Charles McManis	Top soil	0	2
Rt #1 Box 381	Sand	2	80
Woodville, Miss. (mailing address)	clay	80	120
	coarse sand	120	154

WELL LOCATION:
sec. 9 T. 30N R. 2 E
S
6 miles South of DeLesso
(distance) (direction) (nearest town)

WELL PURPOSE: Home
(home, irrigation, municipal, industrial)

- WELL COMPLETION DATA:
- (1) diameter (inches) 2"
 - (2) total depth (feet) 154'
 - (3) static water level (feet) 65' below top of ground.
 - (4) casing (material) Galv. (depth) 147'
 - 2" (size) If telescope see back.
 - (5) screen 5' (length) 147' (depth to top)
 - 2" (size) 55. (material)
 - (6) pump 1 (HP) 6 GPM (yield gpm)
 - elec (type power)
 - (7) electric log no (yes or no)
 - (organization running log)
 - (8) how well bottom plugged Wood Plug

CODED


DEC 16 1970

DRILLERS REMARKS:

MISS. BD. OF
WATER COMM.

If well telescopes please sketch and show depths.

GROUND LEVEL

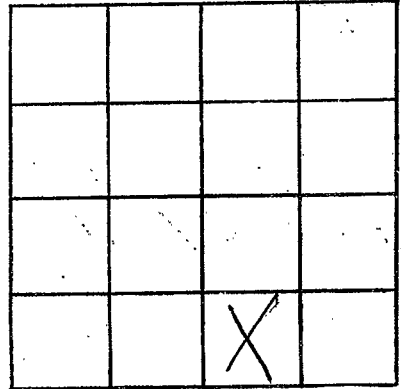

SECTION 9

Please indicate well location X.

ADDITIONAL INFORMATION

If more than one screen,
show locations of each on sketch.