

WILKINSON
G 10
12-19-72

MISSISSIPPI
BOARD OF WATER COMMISSIONERS
416 North State Street
Jackson, Mississippi 39201

CODED

WATER WELL DRILLERS LOG

Date well completed Dec 19 1972 firm name Chateaufort county well located Wilkinson

LANDOWNER: Felix Beath
KFD
Woodville
(mailing address)

WELL LOCATION:
sec. 50 T 3 N R 2E
5 1/2 miles N of Woodville
(distance) (direction) (nearest town)

WELL PURPOSE: domestic
(home, irrigation, municipal, industrial)

WELL COMPLETION DATA:

- (1) diameter (inches) 1 1/2"
- (2) total depth (feet) 154'
- (3) static water level (feet) 65' below above top of ground.
- (4) casing Plastic (material) 154' (depth)
if telescope see back.
(size)
- (5) screen 6' (length) 152' (depth to top)
4" (size) plastic (material)
- (6) pump 1/2 sub (HP) 12 (yield gpm)
flex (type power)
- (7) electric log no (yes or no)
(organization running log)

description of formations encountered	from	to
chack	0	114
white sand gravel	114	38
blue chack	38	134
fine blue sand	134	145
coarse white sand	145	154

CODED


(8) how well bottom plugged water plug
DRILLERS REMARKS: new house

MAR 1 1973

MISS. BD. OF
WATER COM.

If well telescopes please sketch and show depths.

GROUND LEVEL

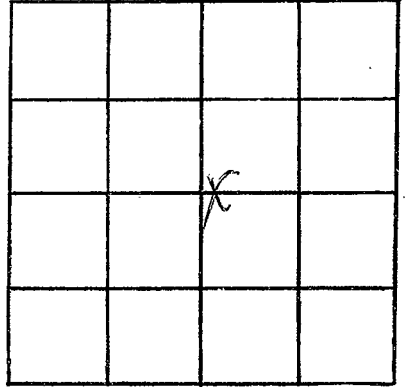

SECTION 50

Please indicate well location X.

ADDITIONAL INFORMATION

If more than one screen,
show locations of each on sketch.