

WILKERSON
 612
 11-23-74

MISSISSIPPI
 BOARD OF WATER COMMISSIONERS
 416 North State Street
 Jackson, Mississippi 39201

CODED

WATER WELL DRILLERS LOG

Mar. 23 1974
 date well completed

Chester Prewer
 firm name

Wilkinson
 county well located

LANDOWNER:	description of formations encountered	from	to
Wilmon Perry Rt. Woodville (mailing address)			
WELL LOCATION: sec. 7 T. 3 N R. 2 W 4 miles South of Bolson (distance) (direction) (nearest town)			
WELL PURPOSE: home (home, irrigation, municipal, industrial)			
WELL COMPLETION DATA: (1) diameter (inches) 4" (2) total depth (feet) 172 (3) static water level (feet) 84 below top of ground. (4) casing plastic bottom (material) (depth) (size) If telescope see back. (5) screen 6" 166 (length) (depth to top) 1/2" plastic (size) (material) (6) pump 1/2 sub 10 (HP) (yield gpm) elect (type power) (7) electric log no (yes or no) (organization running log) (8) how well bottom plugged wooden plug			
DRILLERS REMARKS: no present well find place to make well sand fine			


CODED

RECORDED

MAR 31 1975

If well telescopes please sketch and show depths.

GROUND LEVEL

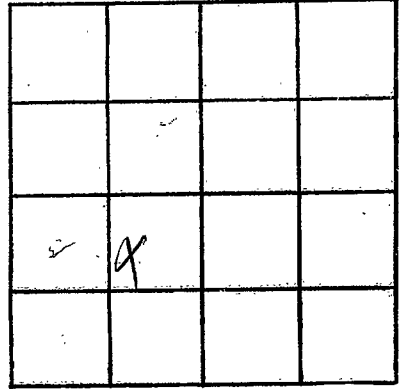

SECTION 7

Please indicate well location X.

ADDITIONAL INFORMATION

If more than one screen, show locations of each on sketch.