

WILKINSON

G 19

7-27-79

MISSISSIPPI BOARD OF WATER COMMISSIONERS
416 North State Street
Jackson, Mississippi 39201

CODED

WATER WELL DRILLERS LOG

Sept-27 1979 Rever Well Co Wilkinson
date well completed firm name county well located

LANDOWNER:	description of formations encountered	from	to
<u>Martin Lewis</u>			
<u>P.O. Box Woodville</u> (mailing address)	<u>Clay</u>	<u>0</u>	<u>12</u>
	<u>blue chalk</u>	<u>12</u>	<u>35</u>
	<u>fine sand</u>	<u>35</u>	<u>180</u>
	<u>Coarse sand</u>	<u>780</u>	<u>195</u>
		<u>195</u>	<u>212</u>
WELL LOCATION: sec <u>51</u> T <u>3</u> N R <u>20</u> W <u>5</u> miles <u>north</u> of <u>Woodville</u> (distance) (direction) (nearest town)			
WELL PURPOSE: <u>house</u> (home, irrigation, municipal, industrial)			
WELL COMPLETION DATA:			
(1) diameter (inches) <u>4"</u>			
(2) total depth (feet) <u>212'</u>			
(3) static water level (feet) <u>80</u> below top of ground.			
(4) casing <u>plastic bottom</u> (material) (depth)			
(5) screen <u>10'</u> <u>202'</u> (length) (depth to top)			
<u>4"</u> <u>plastic</u> (size) (material)			
(6) pump <u>gas</u> (HP) (yield gpm)			
<u>shot</u> (type power)			
(7) electric log <u>no</u> (yes or no)			
<u>N</u> (organization running log)			
(8) how well bottom plugged <u>Water plug</u>			
DRILLERS REMARKS:			

CODED


DEPT. OF NATURAL RESOURCES
BUREAU OF LAND & WATER RESOURCES

SEP 2 - 1980

RECEIVED

If well telescopes please sketch and show depths.

GROUND LEVEL

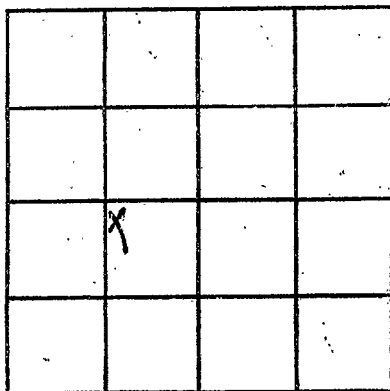

SECTION 57

Please indicate well location X.

ADDITIONAL INFORMATION

If more than one screen,
show locations of each on sketch.