

MISSISSIPPI DEPARTMENT OF NATURAL RESOURCES

Bureau of Land and Water Resources

Southport Mall

P.O. Box 10631

CODED

Jackson, Mississippi 39209

WATER WELL DRILLERS LOG


WILKINSON  
521  
12/31/81

12-31 1981 date well completed  
Rayburn Drill. & Const. Co. firm name  
Wilterson county well located

LANDOWNER:	description of formations encountered	from	to
New F Hughes Drill Co Natchez, MS (mailing address)	Top soil	0	2
WELL LOCATION: sec 39 T 3 N R 2 E 3 1/2 miles SW of Buffalo (distance) (direction) (nearest town)	Sand	2	70
WELL PURPOSE: (home, irrigation, municipal, industrial)	Gumbo	70	370
WELL COMPLETION DATA: (1) diameter (inches) 3"	Sand	370	420
(2) total depth (feet) 420'	<p style="text-align: center;">CODED</p> <p style="text-align: center;">Crosby 39-14A</p> <p style="text-align: center;">330' S + 330' E of NW/Cor SE SW Sec. 39</p>		
(3) static water level (feet) 80' below top of ground			
(4) casing (material) blk (depth) 400'			
(5) screen (length) 20' (depth to top) 400'			
(6) pump (HP) (yield gpm) 426 gpm			
(7) electric log (yes or no) no			
(8) how well bottom plugged wood plug			
DRILLERS REMARKS:	<p style="text-align: center;">DEPT. OF NATURAL RESOURCES BUREAU OF LAND &amp; WATER RESOURCES</p> <p style="text-align: center;">JAN 12 1982</p> <p style="text-align: center;">RECEIVED</p>		

If well telescopes please  
sketch and show depths.

GROUND LEVEL

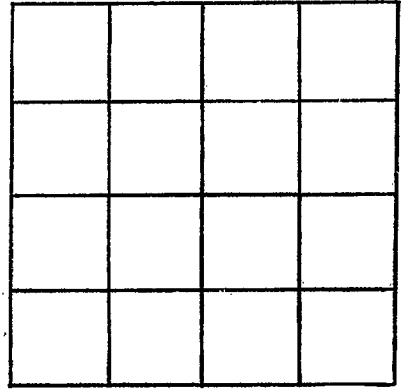

SECTION \_\_\_\_\_

Please indicate well location X.

ADDITIONAL INFORMATION

If more than one screen,  
show locations of each on sketch.