

MISSISSIPPI DEPARTMENT OF NATURAL RESOURCES  
 Bureau of Land and Water Resources  
 Southport Mall  
 P.O. Box 10631  
 Jackson, Mississippi 39209  
**WATER WELL DRILLERS LOG**

**CODED**

Wilkinson  
 522  
 2-9-82

2-9-1982 date well completed  
 82 Rayborn Drill, & Cond Co. firm name  
 Wilkinson county well located

LANDOWNER:	description of formations encountered	from	to
Shamrock Drill	Top soil	0	2
Natchez, MS (mailing address)	gumbo	2	120
WELL LOCATION:	Sand	120	200
sec. 8 T. 30 <sub>S</sub> R. 2 E	broken sand	200	300
(distance) miles (direction) of (nearest town)	Sand	300	385
WELL PURPOSE: (home, irrigation, municipal, industrial)			
WELL COMPLETION DATA:			
(1) diameter (inches) 3"			
(2) total depth (feet) 385'			
(3) static water level (feet) 120' below top of ground.			
(4) casing 3" (material) 365' (depth)			
3" (size) If telescope see back.			
(5) screen 30' (length) 365' (depth to top)			
3" (size) slotted pipe (material)			
(6) pump 6.5 GPM (HP) (yield gpm)			
(type power)			
(7) electric log (yes or no)			
(organization running log)			
(8) how well bottom plugged			
DRILLERS REMARKS:			

fr SE/4 Sec 8 gp  
 Nalg Sec / L 1577' JK  
 W @ R A 1121' to loc  
 Chaffin #1

**CODED**


DEPT. OF NATURAL RESOURCES  
 BUREAU OF LAND & WATER RESOURCES

FEB 15 1982

**RECEIVED**

If well telescopes please  
sketch and show depths.

GROUND LEVEL

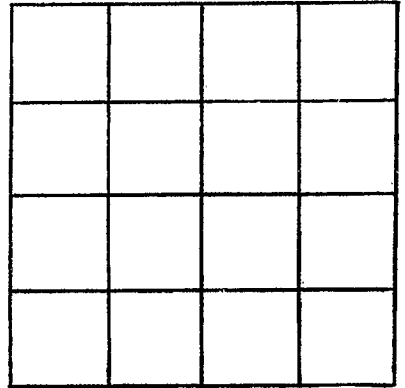

SECTION \_\_\_\_\_

Please indicate well location X.

ADDITIONAL INFORMATION

If more than one screen,  
show locations of each on sketch.