

MISSISSIPPI DEPARTMENT OF NATURAL RESOURCES

Bureau of Land and Water Resources

Southport Mall

P.O. Box 10631

Jackson, Mississippi 39209

WATER WELL DRILLERS LOG

CODED

WILKINSON
523
5-21-82

5-21 1982 Rayborn Drilling Wilkinson
 date well completed firm name county well located

LANDOWNER:
 Inou Drilling
 Natchez, Mo
 (mailing address)

description of formations encountered	from	to
top soil	0	2
chalk	2	340
sand	340	390

WELL LOCATION:
 sec 2 T 3 N R 2 E
 S W
 3 miles NN of Wilkinson
 (distance) (direction) (nearest town)

WELL PURPOSE:
 (home, irrigation, municipal, industrial)

- WELL COMPLETION DATA:
- (1) diameter (inches) 3"
 - (2) total depth (feet) 390'
 - (3) static water level (feet) 120' ^{below} above top of ground.
 - (4) casing 1 1/2" (material), 370' (depth)
 3" (size) if telescope see back.
 - (5) screen 20' (length), 370' (depth to top)
 3" (size) slotted pipe (material)
 - (6) pump (HP) 50 (yield gpm)
 elec (type power)
 - (7) electric log (yes or no)

CODED
 MASHY A-7

(organization running log)

(8) how well bottom plugged wood plug

DRILLERS REMARKS:


DEPT. OF NATURAL RESOURCES
 BUREAU OF LAND & WATER RESOURCES

MAY 31 1982

RECEIVED

If well telescopes please
sketch and show depths.

GROUND LEVEL

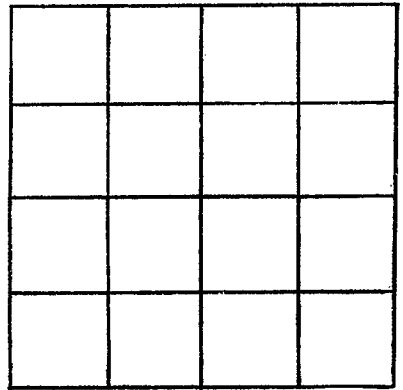

SECTION _____

Please indicate well location X.

ADDITIONAL INFORMATION

If more than one screen,
show locations of each on sketch.