
•			
	State Well R	eport	
County: Wilkinson	Part 1	•	For Office Use Only:
	Mississippi Department of Env	vironmental Quality	Aquifer: <u>G 33</u>
Permit #:	Office of Land and Wat	er Resources	Well #:
Driller: Gary Rayborn	P.O. Box 10631		
Driller: <u>Curry 1 Curportion</u>	Jackson, MS 3928		L. S. Elevation:
Date drilling completed: <u>9-13-10</u>	(601)961-52		E-log #:
·	(601)354-6938	(1ax)	Е-юд #
State Law requires that this rep 30 days of completion of drilling	ort be prepared by the driller	in detail and filed v	with the Department within
<u>So days of completion of drama</u> Well Owner Informa	tion	Wel	ll Location
Owner Name_Michael M		de: 31 . 15 .11	_" Longitude: <u>91016,266</u> ,"
Mailing Address: 403 Wood		d of Lat/Long (circle o	one): Conventional Survey,
		USGS quad, Hand-hel	d GPS, Survey-grade GPS
Berwick La	70342 NE	-	Twn <u>3N Rng 2W</u>
City St	ate Zip Code	Direction	Nearest Town
Telephone No. (985 714 -	1568 10	Miles NINE	of Woodur lle
	Well Data		
	Installa Dublia Commun. Inde-	tion Eich Culture	Other:
Purpose of Well (circle one) Home Ind Date well drilling started:			
If flowing, method of flow regulation: Va			
Static Water Level:feet a	bove of below (circle one) land sur	face Date measured	<u> </u>
Method of Measurement (circle one)	teel tane (electric tane) a	ir line other:	
Hole depth: <u>310</u> Well de	epth: <u>310</u> Wel		
Type of grout (circle one): Cement			
Casing length: 290 feet Cas	ing diameter 4 inch	es Type of casing:	PVC
Screen length:feet Scr			PVC
Screen slot size: O O inches			
Type of completion (circle all applicable)	Gravel packed Underreamed	Telescoped Ope	en noie Natural Development
	Other (describe):		
Top of lap pipe or reduction in casing:	feet. If telescop	ed or more than one so	creen, describe on back of page
Logs run (circle all applicable): No log r	un Electric Gamma Ray Dens	ity Sonic Neutron	Other:
Name of organization running log(s): I certify that the well was drilled, const	ructed and completed in accords	ance with all applicabl	e requirements of the Mississippi
Department of Environmental Quality			
1 -	and/or the Mississippi Departme	It of meanin regulation	is and state in wis.
RAYEORN DRILLING, INC.	0-60	7	-1-
Print Name of Water Well Contractor and	1 License No.	Signature	of Water ell Contractor
26 prove			OCT 1 3 2010
			SY: ULW

If well telescopes please sketch below and show depths.



Description of Formations Encountered	From	To
Large Clay Gravel	0	35
CHALK	35	80
FINE SAND	80	120
CHALK	120	260
SAND	260	310
· · · · · · · · · · · · · · · · · · ·		

If more than one screen, show location of each on sketch

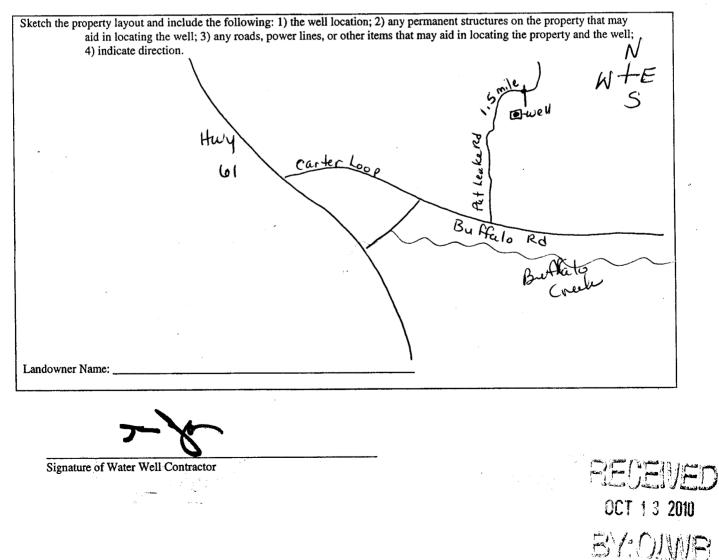

....

	ELL REPORT		
County: Wilkinson Pump Installer' Mississippi Department	Part 2 S Completion Report nt of Environmental Quality Aquifer:		
Driller: GaryRayborn P.O. Jackson, I	and Water Resources		
	1)961-5210 54-6938 (fax)		
This report should be prepared by the pump installer in deta installation of pump.			
Well Owner Information	Well Location		
owner Name: Michael Wise	Latitude: Longitude:		
Mailing Address: 403 Woodburn Lane	Method of Lat/Long (circle one): Conventional Survey, USGS quad, Hand-held GPS, Survey-grade GPS 1414 SecTwn_ <u>3N</u> Rng <u>2W</u> Distance Direction Nearest Town O_Miles <u>N/NE</u> of <u>Woodu</u> , <u>lle</u>		
A00126 1 1 10242			
Berwick La 70342 City State Zip Code			
Telephone No. (985) 714 - 1568			
Ритр Туре	Power Type		
Circle one	Circle one		
Air Lift Jet Submersible	Diesel Engine Gasoline Engine Natural Gas		
Bucket Piston Turbine	Electric Motor Hand Tractor PTO		
Centrifugal Rotary Flowing Well	Windmill Other (specify):		
Other (specify):	Horse Power Rating of Motor: <u>2HP</u>		
Date Pump Installed: <u>9-13-10</u>	Setting Depth:feet		
Rated Pump Capacity:	Number of Stages:		
Pump Test Data	Method of Measuring Water Level		
Date Well Tested: 9 -1 3 - 1 0	Circle one		
Static Water Level (A):Feet Below Land Surface	Air Line Electric Measuring Line Steel Tape		
Pumping Water Level (B):Feet Below Land Surface	Other (specify):		
Drawdown [(B) – (A)]:Feet Below Land Surface	For flowing well, measured shut in head:feet		
Test Pumping Rate: <u>20</u> Gallons Per Minute	Well yielded <u>20</u> GPM with a drawdown of		
Duration of Pump Test (minimum 4 hours):hours	feet afterhours of pumping		
I HEREBY CERTIFY that the above statements are true to the best Gary Rayborn 0-60	or my knowledge.		
Print Name of Pump Installer and License No. (if applicable)	Signature of Pump Installer		
an an ann an Ann an Ann an	and the second sec		
	OCT 13 20		
	BYCOW		