

Wilkinson

G 2000

6/18/76

14E

MISSISSIPPI
 BOARD OF WATER COMMISSIONERS
 416 North State Street
 Jackson, Mississippi 39201

WATER WELL DRILLERS LOG

June 18 1976 Reuss Well Co. Wilkinson
 date well completed firm name county well located

LANDOWNER:

Marion Yarborough
At Wadville
 (mailing address)

description of formations encountered

from to

<u>Clay</u>	<u>0</u>	<u>12</u>
<u>blue Chalk</u>	<u>12</u>	<u>76</u>
<u>Carroll sand</u>	<u>76</u>	<u>90</u>

WELL LOCATION:

sec. 50 T. 3 N. R. 2 E
4 1/2 miles north of Wadville
 (distance) (direction) (nearest town)

WELL PURPOSE: Trailer
 (home, irrigation, municipal, industrial)

WELL COMPLETION DATA:

- (1) diameter (inches) 4
- (2) total depth (feet) 90
- (3) static water level (feet) 49 below top of ground.
- (4) casing plastic bottom
 (material) (depth)
- (size) if telescope see back.
- (5) screen 6' 8 1/4'
 (length) (depth to top)
- 1/2" plastic
 (size) (material)
- (6) pump 1/2 10
 (HP) (yield gpm)
- electric
 (type power)
- (7) electric log no
 (yes or no)
- (organization running log)

RECEIVED
 OCT - 7 1976

(8) how well bottom plugged:

Wadville plug


DRILLERS REMARKS:

no present well

MISS. BD. OF WATER COMMISSIONERS

If well telescopes please sketch and show depths.

GROUND LEVEL

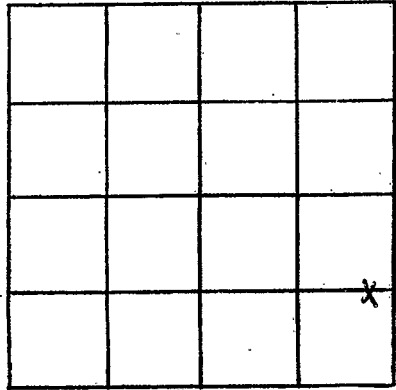

SECTION 50

Please indicate well location X.

ADDITIONAL INFORMATION

If more than one screen, show locations of each on sketch.